OMAHA PUBLIC SCHOOLS ADDENDUM No. 2



### Omaha Public Schools Department of District Operational Services Purchasing Division

BID No.: 26-004 Date: July 25, 2025

### Addendum No. 2 to Bid Documents for OPS North and Northwest High School Cooling Tower Replacement Project

The purpose of this Addendum No. 2 is to modify Bid 26-004, OPS North and Northwest High School Cooling Tower Replacement Project. Except as specifically modified by this Addendum No. 2, the Bid Documents shall remain in effect as originally issued.

The Bid Documents are hereby amended as follows:

1. Project Construction Drawings: See Revised Project Drawings with the engineer notes.

IMPORTANT: Applicants should acknowledge the receipt of this Addendum No. 2 by a notation in the Bid submitted by the Bidder in the manner as required by the Bid Documents.



July 25, 2025 <u>ADDENDUM #2</u>

Ref: OPS North and Northwest Cooling Tower Replacement Project

See updated pdf 25023-OPSNorth&NorthwestCoolingTowers BDH Addm02-072525.pdf for updated documents.

### Addendum #2 changes:

### Sheet E0.1 -

Showed Main Switchboard Location and clarified intent to remove portion of feeder conduit for extension into main switchboard. Showed 480V circuit breaker and transformer and added notes requiring field verification of location of 208V panel that is served by that transformer. Revised KN 1 to clarify 120V ckt sizes/configurations. Revised KN 2 to change feeder to (2) sets of 3#4, 1#8 Ground in existing 1-1/2" conduit to coordinate with Factory Provided Panel requiring 80A MOCP.

### Sheet E0.2 -

Ground in existing 1-1/2" conduit to coordinate with Factory Provided Panel requiring 80A MOCP.

#### Sheet F0.3 -

Revised KN 1 to indicate portion of conduit removal to MCC-A. Revised KN2 to clarify removal of VFD's and associated line and load conduit/conductors. Revised KN 5 to indicate removal of 6x6x4 j-box.

#### Sheet E0.4 –

Identified Location of Panel PP1. Clarified Name of 208V panel as Panel "KP". Revised KN 1 to clarify removal of VFD's and associated line and load conduit/conductors. Revised KN2 to clarify 1-1/2" conduit is existing.

### Sheet E1.1 -

Revised KN 1 to clarify 120V ckt sizes/configurations. Revised KN 2 to change feeder to (2) sets of 3#4, 1#8 ground in existing 1-1/2" conduit. Revised KN 3 to indicate providing 1" conduit with 3#4, 1#8 ground from new j-box at cooling tower to new disconnect switch. Revised KN 4 to indicate providing 3/4" conduit with 3#10, 1#10 ground from factory panel to factory provided VFD's, also indicate providing 3/4" conduit with 3#8, 1#10 ground from factory panel to basin heaters. Revised KN 5 to indicate VFD provided with cooling tower. Revised KN 6 to indicate 100A disconnect instead of 200A disconnect. Revised KN 10 to indicate breaker work at the main switchboard and conduit/conductor extension into existing switchboard. Added KN 13 to indicate Field Verification required to locate 120/208V panel for new 120V ckts that are required. Added KN 14 to indicate providing a new 12X12X4 pullbox. Showed location of BMS control panel, and transformer and circuit breaker. Changed 120V ckt routing to homerun to indicate requirement to field verify its routing. Added a disconnect switch at cooling tower for connection to 2nd factory provided panel. Clarified Panel "KP" rating and # of positions available.

### Sheet E1.2 -

Clarified Panel "KP" rating and # of positions available. Clarified the existing 1-1/2" conduit is exiting to remain. Revised KN 6 to indicated 120V ckt configurations. Revised KN 2 to indicate providing new 3#1/0, 1#6 ground in existing 1-1/2" conduit. Revised KN3 to indicate VFD provided with cooling tower. Revised KN 4 to indicate providing 1" conduit with 3#6, 1#10 ground from factory provided panel to factory provided VFD's. Also indicated providing 3/4" conduit with 3#8, 1#10 ground from factory provided panel to basin heaters. Added KN 10 to indicate 20A ckt connections to available spaces in Panel "KP".

### Sheet E2.1 -

Added sheet - Shows demo and new work one-line diagrams for Work at Switchboard in North Cooling Tower and work in PP1 at Northwest Cooling Tower.

MECHANICAL/ELECTRICAL BDH Engineering 440 Regency Pkwy; Suite 135 Omaha, NE 68114 402 981 5527

# OPS NORTH & NORTHWEST COOLING TOWER REPLACEMENT

### **GENERAL NOTES**

- 1. THE GENERAL CONTRACTOR SHALL VERIFY THE EXISTING/ACTUAL DIMENSIONS AND CONDITIONS SHOWN ON
- 3. THE GENERAL CONTRACTOR SHALL BE RESPONSIBLE FOR ALL CONSTRUCTION MEANS AND METHODS.
- 4. PROVIDE ALL SPECIFIED PRODUCTS/MATERIALS UNLESS OTHERWISE NOTED OR APPROVED BY OWNER, ARCHITECT, OR

OMAHA, NE

### **INDEX OF DRAWINGS**

GENERAL				
Sheet Number		Sheet Name		
COVER PAGE				
G0.0	COVER SHEET			
Grand total: 1				

	MECHANICAL
Sheet Number	Sheet Name
MECHANICAL	
M0.0	MECHANICAL SYMBOLS LEGEND AND GENERAL NOTES
M0.1	NORTH MECHANICAL KEY PLAN
M0.2	NORTHWEST MECHANICAL KEY PLAN
M0.3	NORTH MECHANICAL DEMOLITION PLAN
M0.4	NORTHWEST MECHANICAL DEMOLITION PLAN
M1.1	NORTH MECHANICAL PLAN
M1.2	NORTHWEST MECHANICAL PLAN
M7.1	MECHANICAL DETAILS AND SCHEDULES
Grand total: 8	

ELECTRICAL				
Sheet Number	Sheet Name			
ELECTRICAL				
E0.0	ELECTRICAL SYMBOLS LEGEND AND GENERAL NOTES			
E0.1	NORTH ELECTRICAL KEY PLAN			
E0.2	NORTHWEST ELECTRICAL KEY PLAN			
E0.3	NORTH ELECTRICAL DEMOLITION PLAN			
E0.4	NORTHWEST ELECTRICAL DEMOLITION PLAN			
E1.1	NORTH ELECTRICAL PLAN			
E1.2	NORTHWEST ELECTRICAL PLAN			
E2.1	ELECTRICAL ONE-LINE DIAGRAMS			
Grand total: 8				

### **STANDARD ABBREVIATIONS**

<u> </u>	INDARD ABBRE	V IA I	10143
·C	AID CONDITIONING	IANI	IANITOD
.C '=	AIR CONDITIONING ARCHITECT/ENGINEER	JAN	JANITOR KITCHEN
וטכ	ADDITIONAL		LABORATORY
).J	ADJUSTABLE		LAVATORY
FF.	ABOVE FINISHED FLOOR		LEVEL
-S	ABOVE FINISHED SLAB	LW	LIGHTWEIGHT
	ALUMINUM		MOISTURE RESISTANT
MT	ALUMINUM AMOUNT		MAINTENANCE
NOD	ANODIZED		MATERIAL
	ADDITIONAL		MAXIMUM
	ADDENDUM	MDF	MEDIUM DENSITY
ΩJ	ADJUSTABLE		FIBERBOARD MECHANICAL
FF	ABOVE FINISH FLOOR	MECH.	MECHANICAL
-S	ABOVE FINISH SLAB		MEZZANINE
_L	AROUNTEGE/URAL		MANUFACTURING
KUH.	ARCHITECT(URAL) ACQUSTIC CEILING TILE	MICC	MANUFACTURER MISCELLANEOUS
	ACOUSTIC CEILING TILE AVENUE		MULTIPLE
V.L =	BELOW FINISH FLOOR		NORTH
	BUILDING		NOT APPLICABLE
	BOTTOM OF		NOT IN CONTRACT
OT.	BOTTOM		NOMINAL
RG	BEARING	NTS	NOT TO SCALE
	BASEMENT		OWNER FURNISHED
P	CAST IN PLACE		CONTRACTOR INSTALLED
J	CONTROL JOINT	OFF	OFFICE
L	CLEAR	OFOL	OWNER FURNISHED
LG	CEILING		OWNER INSTALLED
ST	CLOSET	OH	OVERHEAD
	CLEAR		OPPOSITE
	CONCRETE MASONRY UNIT	OPT	OPTIONAL
ONC.	CONCRETE		ORIGINAL
	CONFERENCE		PAINT
ONI	CONTINUOUS		PLASTIC LAMINATE
DOKI	DCOORDINATE		PLYWOOD
۲J	CARPET CERAMIC TILE		POLYSTYRENE
	DBL		SOPOLYISOCYANURATE PAIR
	DEMOLISH		BPREFABRICATED
EDT.	DEPARTMENT		MPRELIMINARY
	DRINKING FOUNTAIN		POLYVINYL CHLORIDE
M	DIMENSION		QUANTITY
ST	DISTANCE		REFERENCE
S	DOWNSPOUT		REQUIRED
W	DISHWASHER		REVERSE/REVISION
WG	DRAWING		ROUGH OPENING
WR	DRAWER	S	SOUTH/STAIN
	EAST	SC	SOLID.CORE
4	EACH		SCHEDULE
FS	EXTERIOR INSULATION &		SOLID CORE WOOD
	FINISH SYSTEM		SQUARE FEET
J	FINISH SYSTEM EXPANSION JOINT		SINGLE
_EC_	ELECTRICAL	SIM	SIMILAR
_EV_	ELEVATOR		SPECIFICATION
MER.	EMERGENCY	SQ	SQUARE
	ENCLOSURE		STAINLESS STEEL
NGK.	ENGINEER EXPANDED POLYSTYRENE		STREET STANDARD
	EQUAL		STANDARD
	EXTERIOR		T STRUCTURAL
=	FIRE EXTINGUISHER		SUSPENDED
	FIXTURES FURNITURE &	T&B	TOP & BOTTOM
	EQUIPMENT		TONGUE & GROOVE
E	FINISH FLOOR ELEVATION		TO BE DETERMINED
	FLANGE/FLASHING/FLOORING		TEMPORARY
	FLOOR	THRU	THROUGH
PRG	FIREPROOFING	TLT	TOILET/TOILET ROOM
	FT		TOP OF
	FOOTING		TYPICAL
JT	FUTURE		UNFINISHED
/	FIELD VERIFY	UNQ	UNLESS NOTED OTHERWISE
ALV.	GALVANIZED	UTIL	UTILITY
	GENERAL CONTRACTOR		VINYL COMPOSITION TILE
	GYPSUM PLASTER		VERTICAL
WB	GYPSUM WALL BOARD	VES.I	VESTIBULE
ار ا	HOLLOW CORE	V.V	WEST
טפט מיייי	HARDBOARD	V.V.	WITHOUT
יאטר. הסח	HARDWOOD HARDWARE	₩/.Û \///Þ	WITHOUT WATER RESISTANT
MI עראר™	HOLLOW METAL		WATER CLOSET
OR17	HORIZONTAL	WHSE	WATER CLOSE I
	HEIGHT	WMT	WAKETIOUSE WAKETIOUSE
VAC	HEATING, VENTILATION,		Tracia-Verta-Japan
	& AIR CONDITIONING		
SUL	INSULATION		
	INTERIOR		

INTERIOR





OPS NORTH & NORTHWEST COOLING TOWER REPLACEMENT


OMAHA, NE

**COVER SHEET** 



This document and the information contained may

not be reproduced or excerpted from without the express written permission of BDH Engineering, LLC. Unauthorized copying, disclosure or construction use are prohibited by the copyright law

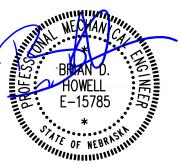

25023

**BID NUMBER 26-004** 

DESIGN PROFESSIONAL'S ELECTRONIC OR DIGITAL SEAL OR SIGNATURE IS EFFECTIVE ONLY AS TO THAT VERSION OF THIS DOCUMENT AS ORIGINALLY PUBLISHED BY DESIGN PROFESSIONAL. DESIGN PROFESSIONAL IS NOT RESPONSIBLE FOR ANY SUBSEQUENT MODIFICATION, CORRUPTION, OR UNAUTHORIZED USE OF SUCH DOCUMENT. TO VERIFY THE VALIDITY OR APPLICABILITY OF THE SEAL OR SIGNATURE CONTACT DESIGN PROFESSIONAL.

Coordinating Professional on the OPS NORTH & TOWER REPLACEMENT

## PLUMBING AND MECHANICAL SYMBOLS LEGEND

SYMBOL	DESCRIPTION	PIPIN SYMBOL	NG AND SPECIALTIES  DESCRIPTION	SYMBOL	DESCRIPTION
== RD ===	REFRIGERANT DISCHARGE	==PGR==	PROPYLENE GLYCOL RETURN	— D—	INLINE PUMP
==RL ===	REFRIGERANT LIQUID	=== PGS===	PROPYLENE GLYCOL SUPPLY	₩v	
== RS ===	REFRIGERANT SUCTION	FOR	FUEL OIL RETURN		AIR VENT - MANUAL
	COIL CONDENSATE DRAIN	== FOS==	FUEL OIL VENT	A	AIR VENT - AUTOMATIC
	LOW PRESSURE STEAM (PRESSURE)  MEDIUM PRESSURE STEAM (PRESSURE)	==FOV== ==CR==	FUEL OIL VENT  CONDENSER WATER RETURN	FS FS	FLOW SWITCH
	HIGH PRESSURE STEAM (PRESSURE)	cs	CONDENSER WATER SUPPLY	PS PS	PRESSURE SWITCH
	LOW PRESSURE CONDENSATE	=HPWR=	HEAT PUMP WATER RETURN	—() <sub>AS-</sub>	AIR SEPARATOR
─MPC── ─HPC──	MEDIUM PRESSURE CONDENSATE HIGH PRESSURE CONDENSATE	= HPWS=	HEAT PUMP WATER SUPPLY	[]	THERMOMETER
	PUMPED CONDENSATE	—— <u>D</u> —— R	PITCH OF PIPE, RISE (R) OR DROP (D)	$\frac{1}{T}$ TW	THERMOMETER WELL
MU	MAKE-UP WATER	<del></del>	PIPE ANCHOR - MAIN	——————————————————————————————————————	BALL JOINT
	HOT/CHILLED WATER RETURN	— <del>X</del> —	PIPE ANCHOR - INTERMEDIATE	1	
== HCS=== == HWR===	HOT/CHILLED WATER SUPPLY HEATING WATER RETURN	<u>H</u>	HANGER - ROD	PSD—	PUMP SUCTION DIFFUSER
HWS	HEATING WATER SUPPLY	— Н	HANGER - SPRING		FLOAT THERMOSTATIC TRAP FLOWMETER - ORIFICE
CWR	CHILLED WATER RETURN		ALIGNMENT GUIDE	——————————————————————————————————————	FLOWMETER - VENTURI
	CHILLED WATER SUPPLY		FLEX CONNECTOR	<del>8</del>	DUPLEX STRAINER
==EGR=== ==EGS===	ETHYLENE GLYCOL RETURN ETHYLENE GLYCOL SUPPLY		EXPANSION - LOOP	O	
LG5	EIIITEINE GETOOL GOFFET	+	EXPANSION - JOINT		
			DUCTWORK		
ECT. RND. OVAL	SUPPLY (SA), OUTSIDE (OA),	$R \longrightarrow $	ELEVATION CHANGE (RISE OR DROP)	FD▶─	FIRE DAMPER (IN HORIZONTAL DUCT)
	VENTILATION (VA) AIR DUCT (UP/DOWN/SECTION)	' <u></u> '	HIGH EFF. TAKE OFF FITTING WITH VOLUME DAMPE	R SD⊳—	SMOKE DAMPER (IN HORIZONTAL DUCT
	RETURN (RA) AIR DUCT (UP/DOWN/SECTION)	BD	BACKDRAFT DAMPER	•	FIRE DAMPER (IN VERTICAL DUCT)
	EXHAUST (EA) AIR DUCT (UP/DOWN/SECTION)		TURNING VANES	SD ♦—	SMOKE DAMPER (IN VERTICAL DUCT)
10/6 SA	RECTANGLE DUCT (WIDTH/HEIGHT/SYSTEM)	──VD	VOLUME CONTROL DAMPER	FSD▶⊳	FIRE/SMOKE DAMPER (IN HORIZONTAL
10 Ø SA S	ROUND DUCT (DIAMETER/SYSTEM)	IVD	VOLUME CONTROL DAMPER  VOLUME CONTROL DAMPER	FSD <b>♦</b> ♦	FIRE/SMOKE DAMPER (IN VERTICAL DUC
10/6 Ø SA	FLAT OVAL DUCT (WIDTH/HEIGHT/SYSTEM)	× × × ×	OPPOSED BLADE DAMPER		DUCT ACCESS PANEL
++++++++	FLEXIBLE DUCTWORK	p p p p p	PARALLEL BLADE DAMPER	☐RP\	RELIEF PANEL
				CAP	DUCT END CAP
			H.V.A.C.	_ <del>_</del>	
	SUPPLY DIFFUSER		VAV TERMINAL UNIT	<b>T</b>	THERMOSTAT
				$\odot_G$	THERMOSTAT WITH GUARD
	SUPPLY REGISTER		FAN POWERED VAV TERMINAL UNIT	®XX-X	TEMPERATURE SENSOR - XX-X DENOTES SERVED
====	SUPPLY SLOT DIFFUSER	$\overline{}$		©co	CARBON MONOXIDE SENSOR
	RETURN REGISTER	Ш	SIDE WALL DIFFUSER	© <sub>CO2</sub>	CARBON DIOXIDE SENSOR
			ROUND DIFFUSER	© <sub>NOX</sub>	NITROGEN DIOXIDE SENSOR
	RETURN GRILLE		EXTERIOR LOUVER	© <sub>H</sub>	HUMIDITY SENSOR
	EXHAUST REGISTER	$\bigcup$	EXTENSIVES	® <sub>P</sub>	PRESSURE SENSOR
	EXHAUST GRILLE	→ X  CFM	SUPPLY IDENTIFICATION TAG X DENOTES TYPE	© <sub>G</sub>	TEMPERATURE SENSOR WITH GU
		X	RETURN/ EXHAUST/LOUVER IDENTIFICATION TAG	G (H)	HUMIDISTAT
	DUAL DUCT TERMINAL UNIT	CFM IV	X DENOTES TYPE	Ho	EMERGENCY SHUTDOWN SWITCH
		<u>M</u> -	MOTORIZED ACTUATOR  PNEUMATIC ACTUATOR		
		igoplus			
			FITTINGS		
			FILLINGS		
SINGLE DOUBLE LINE LINE	<u> </u>	SINGLE DOUBI	LE	SINGLE DOU LINE LIN	
LINE LINE	ELBOW	LINE LINE	LE E		NE
LINE LINE  THE	ELBOW LONG RADIUS ELBOW	LINE LINE	LE E E ELBOW - DOUBLE BRANCH	LINE LIN	NE
LINE LINE	ELBOW LONG RADIUS ELBOW	LINE LINE	LE E ELBOW - DOUBLE BRANCH ELBOW - SIDE OUTLET UP	LINE LIN	NE REDUCER - CONCENTRIC
LINE LINE  THE SR SR	ELBOW LONG RADIUS ELBOW SHORT RADIUS ELBOW	LINE LINE  + + + + + + + + + + + + + + + + + +	ELBOW - DOUBLE BRANCH ELBOW - SIDE OUTLET UP ELBOW - SIDE OUTLET DOWN	LINE LIN	REDUCER - CONCENTRIC  REDUCER - ECCENTRIC
LINE LINE  THE SR SR  X A	ELBOW LONG RADIUS ELBOW SHORT RADIUS ELBOW 45° ELBOW	LINE LINE  THE STATE OF THE STA	ELBOW - DOUBLE BRANCH ELBOW - SIDE OUTLET UP ELBOW - SIDE OUTLET DOWN ELBOW - OUTLET DOWN	LINE LIN	REDUCER - CONCENTRIC  REDUCER - ECCENTRIC  CAPPED CONNECTION
LINE LINE  THE SR SR  THE SR	ELBOW LONG RADIUS ELBOW SHORT RADIUS ELBOW 45° ELBOW TEE	LINE LINE  THE STATE OF THE STA	ELBOW - DOUBLE BRANCH ELBOW - SIDE OUTLET UP ELBOW - SIDE OUTLET DOWN ELBOW - OUTLET DOWN ELBOW - OUTLET UP	LINE LIN	REDUCER - CONCENTRIC  REDUCER - ECCENTRIC  CAPPED CONNECTION  THREADED CONNECTION
LINE LINE  THE SR SR  X A	ELBOW LONG RADIUS ELBOW SHORT RADIUS ELBOW 45° ELBOW		ELBOW - DOUBLE BRANCH ELBOW - SIDE OUTLET UP ELBOW - SIDE OUTLET DOWN ELBOW - OUTLET DOWN ELBOW - OUTLET UP TEE - OUTLET DOWN	LINE LIN	REDUCER - CONCENTRIC  REDUCER - ECCENTRIC  CAPPED CONNECTION  THREADED CONNECTION  FLANGED CONNECTION
LINE LINE  THE SR SR  THE SR	ELBOW LONG RADIUS ELBOW SHORT RADIUS ELBOW 45° ELBOW TEE		ELBOW - DOUBLE BRANCH ELBOW - SIDE OUTLET UP ELBOW - SIDE OUTLET DOWN ELBOW - OUTLET DOWN ELBOW - OUTLET UP TEE - OUTLET DOWN TEE - OUTLET DOWN	LINE LIN	REDUCER - CONCENTRIC  REDUCER - ECCENTRIC  CAPPED CONNECTION  THREADED CONNECTION  FLANGED CONNECTION  STRAINER
LINE LINE  THE SR SR  THE SR SR  THE S	ELBOW LONG RADIUS ELBOW SHORT RADIUS ELBOW  45° ELBOW  TEE CROSS		ELBOW - DOUBLE BRANCH ELBOW - SIDE OUTLET UP ELBOW - SIDE OUTLET DOWN ELBOW - OUTLET DOWN ELBOW - OUTLET UP TEE - OUTLET DOWN TEE - OUTLET DOWN	LINE LIN	REDUCER - CONCENTRIC  REDUCER - ECCENTRIC  CAPPED CONNECTION  THREADED CONNECTION  FLANGED CONNECTION  STRAINER  STRAINER WITH BALL VALVE DR
LINE LINE  THE SR SR  THE SR	ELBOW LONG RADIUS ELBOW SHORT RADIUS ELBOW 45° ELBOW TEE CROSS		ELBOW - DOUBLE BRANCH ELBOW - SIDE OUTLET UP ELBOW - SIDE OUTLET DOWN ELBOW - OUTLET DOWN ELBOW - OUTLET UP TEE - OUTLET DOWN TEE - OUTLET UP TEE - SIDE OUTLET DOWN	LINE LIN	REDUCER - CONCENTRIC  REDUCER - ECCENTRIC  CAPPED CONNECTION  THREADED CONNECTION  FLANGED CONNECTION  STRAINER  STRAINER WITH BALL VALVE DR  STRAINER WITH COUPLER
LINE LINE  THE SR SR  THE SR SR  THE S	ELBOW LONG RADIUS ELBOW SHORT RADIUS ELBOW  45° ELBOW  TEE CROSS		ELBOW - DOUBLE BRANCH ELBOW - SIDE OUTLET UP ELBOW - SIDE OUTLET DOWN ELBOW - OUTLET DOWN ELBOW - OUTLET UP TEE - OUTLET DOWN TEE - OUTLET UP TEE - SIDE OUTLET DOWN	LINE LIN	REDUCER - CONCENTRIC  REDUCER - ECCENTRIC  CAPPED CONNECTION  THREADED CONNECTION  STRAINER  STRAINER WITH BALL VALVE DR  STRAINER WITH COUPLER  BUSHING
LINE LINE  THE SR SR  THE SR SR  THE S	ELBOW LONG RADIUS ELBOW SHORT RADIUS ELBOW  45° ELBOW  TEE CROSS		ELBOW - DOUBLE BRANCH ELBOW - SIDE OUTLET UP ELBOW - SIDE OUTLET DOWN ELBOW - OUTLET DOWN ELBOW - OUTLET UP TEE - OUTLET DOWN TEE - OUTLET UP TEE - SIDE OUTLET DOWN TEE - SIDE OUTLET DOWN	LINE LIN	REDUCER - CONCENTRIC  REDUCER - ECCENTRIC  CAPPED CONNECTION  THREADED CONNECTION  STRAINER  STRAINER WITH BALL VALVE DR  STRAINER WITH COUPLER  BUSHING
LINE LINE  THAT SR A 4 4 4 4 4 4 4 4 4 4 4 4 4 4 4 4 4 4	ELBOW LONG RADIUS ELBOW SHORT RADIUS ELBOW  45° ELBOW  TEE CROSS LATERAL TEE - SINGLE SWEEP		ELBOW - DOUBLE BRANCH ELBOW - SIDE OUTLET UP ELBOW - SIDE OUTLET DOWN ELBOW - OUTLET DOWN ELBOW - OUTLET UP TEE - OUTLET DOWN TEE - OUTLET UP TEE - SIDE OUTLET DOWN TEE - SIDE OUTLET DOWN TEE - SIDE OUTLET UP SIAMESE CONNECTION VALVES		REDUCER - CONCENTRIC  REDUCER - ECCENTRIC  CAPPED CONNECTION  THREADED CONNECTION  STRAINER  STRAINER  STRAINER WITH BALL VALVE DR  STRAINER WITH COUPLER  BUSHING  FLOW DIRECTION
LINE LINE  THAT SR A 44 F F F F F F F F F F F F F F F F F	ELBOW LONG RADIUS ELBOW SHORT RADIUS ELBOW  45° ELBOW  TEE CROSS LATERAL TEE - SINGLE SWEEP		ELBOW - DOUBLE BRANCH ELBOW - SIDE OUTLET UP ELBOW - SIDE OUTLET DOWN ELBOW - OUTLET DOWN ELBOW - OUTLET UP TEE - OUTLET DOWN TEE - OUTLET DOWN TEE - SIDE OUTLET DOWN TEE - SIDE OUTLET DOWN TEE - SIDE OUTLET UP SIAMESE CONNECTION VALVES STOP/CHECK GATE VALVE (ARROW IND. FLOW)		REDUCER - CONCENTRIC  REDUCER - ECCENTRIC  CAPPED CONNECTION THREADED CONNECTION  STRAINER STRAINER STRAINER WITH BALL VALVE DR STRAINER WITH COUPLER BUSHING FLOW DIRECTION  MULTIPURPOSE VALVE
LINE LINE  THAT SR A 4 4 4 4 4 4 4 4 4 4 4 4 4 4 4 4 4 4	ELBOW LONG RADIUS ELBOW SHORT RADIUS ELBOW  45° ELBOW  TEE CROSS LATERAL TEE - SINGLE SWEEP		ELBOW - DOUBLE BRANCH ELBOW - SIDE OUTLET UP ELBOW - SIDE OUTLET DOWN ELBOW - OUTLET DOWN ELBOW - OUTLET UP TEE - OUTLET DOWN TEE - OUTLET DOWN TEE - SIDE OUTLET DOWN TEE - SIDE OUTLET DOWN TEE - SIDE OUTLET UP SIAMESE CONNECTION VALVES  STOP/CHECK GATE VALVE (ARROW IND. FLOW) SPRING GATE CHECK VALVE (ARROW IND. FLOW)	LINE LINE  PRV-X	REDUCER - CONCENTRIC  REDUCER - ECCENTRIC  CAPPED CONNECTION  THREADED CONNECTION  STRAINER  STRAINER  STRAINER WITH BALL VALVE DR  STRAINER WITH COUPLER  BUSHING  FLOW DIRECTION
LINE LINE  THAT A 44 F F F	ELBOW LONG RADIUS ELBOW SHORT RADIUS ELBOW  45° ELBOW  TEE CROSS LATERAL TEE - SINGLE SWEEP		ELBOW - DOUBLE BRANCH ELBOW - SIDE OUTLET UP ELBOW - SIDE OUTLET DOWN ELBOW - OUTLET DOWN ELBOW - OUTLET UP TEE - OUTLET DOWN TEE - OUTLET DOWN TEE - SIDE OUTLET DOWN TEE - SIDE OUTLET UP SIAMESE CONNECTION  VALVES  STOP/CHECK GATE VALVE (ARROW IND. FLOW) SPRING GATE CHECK VALVE (ARROW IND. FLOW) SWING GATE CHECK VALVE (ARROW IND. FLOW)	LINE LINE  PRV-X	REDUCER - CONCENTRIC  REDUCER - ECCENTRIC  CAPPED CONNECTION THREADED CONNECTION  STRAINER STRAINER STRAINER WITH BALL VALVE DR STRAINER WITH COUPLER BUSHING FLOW DIRECTION  MULTIPURPOSE VALVE
LINE LINE	ELBOW LONG RADIUS ELBOW SHORT RADIUS ELBOW  45° ELBOW  TEE CROSS LATERAL TEE - SINGLE SWEEP  GATE VALVE  ANGLE GATE VALVE		ELBOW - DOUBLE BRANCH ELBOW - SIDE OUTLET UP ELBOW - SIDE OUTLET DOWN ELBOW - OUTLET DOWN ELBOW - OUTLET UP TEE - OUTLET DOWN TEE - OUTLET DOWN TEE - SIDE OUTLET DOWN TEE - SIDE OUTLET DOWN TEE - SIDE OUTLET UP SIAMESE CONNECTION VALVES  STOP/CHECK GATE VALVE (ARROW IND. FLOW) SPRING GATE CHECK VALVE (ARROW IND. FLOW)	LINE LINE	REDUCER - CONCENTRIC REDUCER - ECCENTRIC CAPPED CONNECTION THREADED CONNECTION STRAINER STRAINER WITH BALL VALVE DR STRAINER WITH COUPLER BUSHING FLOW DIRECTION MULTIPURPOSE VALVE PRESSURE REDUCING VALVE
LINE LINE  THAT A 44 F F F	ELBOW LONG RADIUS ELBOW SHORT RADIUS ELBOW  45° ELBOW  TEE CROSS LATERAL TEE - SINGLE SWEEP  GATE VALVE  ANGLE GATE VALVE  BALL VALVE		ELBOW - DOUBLE BRANCH ELBOW - SIDE OUTLET UP ELBOW - SIDE OUTLET DOWN ELBOW - OUTLET DOWN ELBOW - OUTLET UP TEE - OUTLET DOWN TEE - OUTLET DOWN TEE - SIDE OUTLET DOWN TEE - SIDE OUTLET UP SIAMESE CONNECTION  VALVES  STOP/CHECK GATE VALVE (ARROW IND. FLOW) SPRING GATE CHECK VALVE (ARROW IND. FLOW) SWING GATE CHECK VALVE (ARROW IND. FLOW)	LINE LINE  PRV-X  PRV-X  PRV-X	REDUCER - CONCENTRIC REDUCER - ECCENTRIC CAPPED CONNECTION THREADED CONNECTION STRAINER STRAINER WITH BALL VALVE DR STRAINER WITH COUPLER BUSHING FLOW DIRECTION  MULTIPURPOSE VALVE PRESSURE REDUCING VALVE REDUCED PRESS. BACKFLOW ASSY.
LINE LINE  THAT A HAT THAT IN	ELBOW LONG RADIUS ELBOW SHORT RADIUS ELBOW  45° ELBOW  TEE CROSS LATERAL TEE - SINGLE SWEEP  GATE VALVE ANGLE GATE VALVE BALL VALVE LOCKABLE BALL VALVE		ELBOW - DOUBLE BRANCH ELBOW - SIDE OUTLET UP ELBOW - SIDE OUTLET DOWN ELBOW - OUTLET DOWN ELBOW - OUTLET UP TEE - OUTLET DOWN TEE - OUTLET DOWN TEE - SIDE OUTLET DOWN TEE - SIDE OUTLET UP SIAMESE CONNECTION  VALVES  STOP/CHECK GATE VALVE (ARROW IND. FLOW) SPRING GATE CHECK VALVE (ARROW IND. FLOW) ANGLE STOP/CHECK VALVE	LINE LINE  LINE  PRV-X  PRV-X	REDUCER - CONCENTRIC  REDUCER - ECCENTRIC  CAPPED CONNECTION THREADED CONNECTION STRAINER STRAINER WITH BALL VALVE DR STRAINER WITH COUPLER BUSHING FLOW DIRECTION  MULTIPURPOSE VALVE PRESSURE REDUCING VALVE PRESSURE REDUCING PILOT VALVE REDUCED PRESS. BACKFLOW ASSY.  DOUBLE CHK VALVE BACKFLOW ASSY
LINE LINE  THE SR SR A 44 F F F F F F F F F F F F F F F F F	ELBOW LONG RADIUS ELBOW SHORT RADIUS ELBOW  45° ELBOW  TEE CROSS LATERAL TEE - SINGLE SWEEP  GATE VALVE ANGLE GATE VALVE BALL VALVE LOCKABLE BALL VALVE BUTTERFLY VALVE		ELBOW - DOUBLE BRANCH ELBOW - SIDE OUTLET UP ELBOW - SIDE OUTLET DOWN ELBOW - OUTLET DOWN ELBOW - OUTLET UP TEE - OUTLET DOWN TEE - OUTLET DOWN TEE - SIDE OUTLET DOWN TEE - SIDE OUTLET UP SIAMESE CONNECTION  VALVES  STOP/CHECK GATE VALVE (ARROW IND. FLOW) SPRING GATE CHECK VALVE (ARROW IND. FLOW) ANGLE STOP/CHECK VALVE 2-WAY ELECTROMOTOR VALVE	LINE LINE  PRV-X  PRV-X  PRV-X	REDUCER - CONCENTRIC REDUCER - ECCENTRIC CAPPED CONNECTION THREADED CONNECTION STRAINER STRAINER WITH BALL VALVE DR STRAINER WITH COUPLER BUSHING FLOW DIRECTION  MULTIPURPOSE VALVE PRESSURE REDUCING VALVE REDUCED PRESS. BACKFLOW ASSY.
LINE LINE  THAT A HAT THAT IN	ELBOW LONG RADIUS ELBOW SHORT RADIUS ELBOW  45° ELBOW  TEE CROSS LATERAL TEE - SINGLE SWEEP  GATE VALVE ANGLE GATE VALVE BALL VALVE LOCKABLE BALL VALVE BUTTERFLY VALVE GLOBE VALVE		ELBOW - DOUBLE BRANCH ELBOW - SIDE OUTLET UP ELBOW - SIDE OUTLET DOWN ELBOW - OUTLET DOWN ELBOW - OUTLET UP TEE - OUTLET DOWN TEE - OUTLET UP TEE - SIDE OUTLET DOWN TEE - SIDE OUTLET UP SIAMESE CONNECTION  VALVES  STOP/CHECK GATE VALVE (ARROW IND. FLOW) SPRING GATE CHECK VALVE (ARROW IND. FLOW) ANGLE STOP/CHECK VALVE 2-WAY ELECTROMOTOR VALVE	LINE LINE LINE LINE LINE LINE LINE LINE	REDUCER - CONCENTRIC  REDUCER - ECCENTRIC  CAPPED CONNECTION THREADED CONNECTION STRAINER STRAINER WITH BALL VALVE DR STRAINER WITH COUPLER BUSHING FLOW DIRECTION  MULTIPURPOSE VALVE PRESSURE REDUCING VALVE PRESSURE REDUCING PILOT VALVE REDUCED PRESS. BACKFLOW ASSY.  DOUBLE CHK VALVE BACKFLOW ASSY
LINE LINE  THE SR A 44 F F F F F F F F F F F F F F F F F	ELBOW LONG RADIUS ELBOW SHORT RADIUS ELBOW  45° ELBOW  TEE CROSS LATERAL TEE - SINGLE SWEEP  GATE VALVE ANGLE GATE VALVE BALL VALVE LOCKABLE BALL VALVE BUTTERFLY VALVE GLOBE VALVE ANGLE GLOBE VALVE		ELBOW - DOUBLE BRANCH ELBOW - SIDE OUTLET UP ELBOW - SIDE OUTLET DOWN ELBOW - OUTLET DOWN ELBOW - OUTLET UP TEE - OUTLET DOWN TEE - OUTLET UP TEE - SIDE OUTLET DOWN TEE - SIDE OUTLET UP SIAMESE CONNECTION  VALVES  STOP/CHECK GATE VALVE (ARROW IND. FLOW) SPRING GATE CHECK VALVE (ARROW IND. FLOW) ANGLE STOP/CHECK VALVE 2-WAY ELECTROMOTOR VALVE 2-WAY MANUAL VALVE	LINE LINE LINE LINE LINE LINE LINE LINE	REDUCER - CONCENTRIC REDUCER - ECCENTRIC CAPPED CONNECTION THREADED CONNECTION STRAINER STRAINER WITH BALL VALVE DR STRAINER WITH COUPLER BUSHING FLOW DIRECTION  MULTIPURPOSE VALVE PRESSURE REDUCING VALVE PRESSURE REDUCING PILOT VALVE REDUCED PRESS. BACKFLOW ASSY. DOUBLE CHK VALVE BACKFLOW ASSY DOUBLE DETECTOR CHECK VALVE QUICK CLOSING FUSIBLE LINK VALVE
LINE LINE  THE SR A 44 F F F F F F F F F F F F F F F F F	ELBOW LONG RADIUS ELBOW SHORT RADIUS ELBOW  45° ELBOW  TEE CROSS LATERAL TEE - SINGLE SWEEP  GATE VALVE ANGLE GATE VALVE BALL VALVE LOCKABLE BALL VALVE BUTTERFLY VALVE GLOBE VALVE ANGLE GLOBE VALVE PLUG VALVE		ELBOW - DOUBLE BRANCH ELBOW - SIDE OUTLET UP ELBOW - SIDE OUTLET DOWN ELBOW - OUTLET DOWN ELBOW - OUTLET UP TEE - OUTLET DOWN TEE - OUTLET UP TEE - SIDE OUTLET DOWN TEE - SIDE OUTLET UP SIAMESE CONNECTION  VALVES  STOP/CHECK GATE VALVE (ARROW IND. FLOW) SPRING GATE CHECK VALVE (ARROW IND. FLOW) ANGLE STOP/CHECK VALVE 2-WAY ELECTROMOTOR VALVE 2-WAY MANUAL VALVE 3-WAY ELECTROMOTOR VALVE	LINE LINE LINE LINE LINE LINE LINE LINE	REDUCER - CONCENTRIC  REDUCER - ECCENTRIC  CAPPED CONNECTION THREADED CONNECTION STRAINER STRAINER WITH BALL VALVE DR STRAINER WITH COUPLER BUSHING FLOW DIRECTION  MULTIPURPOSE VALVE PRESSURE REDUCING VALVE PRESSURE REDUCING PILOT VALVE REDUCED PRESS. BACKFLOW ASSY.  DOUBLE CHK VALVE BACKFLOW ASSY DOUBLE DETECTOR CHECK VALVE QUICK CLOSING FUSIBLE LINK VALVE QUICK OPENING VALVE
LINE LINE  FR SR A 4 4 5 5 5 5 5 5 5 5 5 5 5 5 5 5 5 5 5	ELBOW LONG RADIUS ELBOW SHORT RADIUS ELBOW  45° ELBOW  TEE CROSS LATERAL TEE - SINGLE SWEEP  GATE VALVE ANGLE GATE VALVE BALL VALVE BUTTERFLY VALVE GLOBE VALVE ANGLE GLOBE VALVE PLUG VALVE DIAPHRAGM VALVE		ELBOW - DOUBLE BRANCH ELBOW - SIDE OUTLET UP ELBOW - SIDE OUTLET DOWN ELBOW - OUTLET DOWN ELBOW - OUTLET UP  TEE - OUTLET UP  TEE - OUTLET UP  TEE - SIDE OUTLET DOWN  TEE - SIDE OUTLET UP SIAMESE CONNECTION  VALVES  STOP/CHECK GATE VALVE (ARROW IND. FLOW) SPRING GATE CHECK VALVE (ARROW IND. FLOW) ANGLE STOP/CHECK VALVE 2-WAY ELECTROMOTOR VALVE 2-WAY MANUAL VALVE 3-WAY ELECTROMOTOR VALVE 3-WAY AIRMOTOR VALVE	LINE LINE LINE LINE LINE LINE LINE LINE	REDUCER - CONCENTRIC REDUCER - ECCENTRIC CAPPED CONNECTION THREADED CONNECTION STRAINER STRAINER WITH BALL VALVE DR STRAINER WITH COUPLER BUSHING FLOW DIRECTION  MULTIPURPOSE VALVE PRESSURE REDUCING VALVE PRESSURE REDUCING PILOT VALVE REDUCED PRESS. BACKFLOW ASSY. DOUBLE CHK VALVE BACKFLOW ASSY DOUBLE DETECTOR CHECK VALVE QUICK CLOSING FUSIBLE LINK VALVE
LINE LINE  FR SR A 4 4 5 5 5 5 5 5 5 5 5 5 5 5 5 5 5 5 5	ELBOW LONG RADIUS ELBOW SHORT RADIUS ELBOW  45° ELBOW  TEE CROSS LATERAL TEE - SINGLE SWEEP  GATE VALVE ANGLE GATE VALVE BALL VALVE LOCKABLE BALL VALVE BUTTERFLY VALVE GLOBE VALVE ANGLE GLOBE VALVE PLUG VALVE DIAPHRAGM VALVE DIAPHRAGM ACTUATED VALVE VALVE IN VERTICAL LINE		ELBOW - DOUBLE BRANCH ELBOW - SIDE OUTLET UP ELBOW - SIDE OUTLET DOWN ELBOW - OUTLET DOWN ELBOW - OUTLET UP TEE - OUTLET UP TEE - OUTLET UP TEE - SIDE OUTLET DOWN TEE - SIDE OUTLET UP SIAMESE CONNECTION  VALVES  STOP/CHECK GATE VALVE (ARROW IND. FLOW) SPRING GATE CHECK VALVE (ARROW IND. FLOW) ANGLE STOP/CHECK VALVE 2-WAY ELECTROMOTOR VALVE 2-WAY AIRMOTOR VALVE 3-WAY BLECTROMOTOR VALVE 3-WAY AIRMOTOR VALVE 3-WAY AIRMOTOR VALVE 3-WAY AIRMOTOR VALVE 3-WAY MANUAL VALVE	LINE LINE LINE LINE LINE LINE LINE LINE	REDUCER - CONCENTRIC  REDUCER - ECCENTRIC  CAPPED CONNECTION THREADED CONNECTION STRAINER STRAINER WITH BALL VALVE DR STRAINER WITH COUPLER BUSHING FLOW DIRECTION  MULTIPURPOSE VALVE PRESSURE REDUCING VALVE PRESSURE REDUCING PILOT VALVE REDUCED PRESS. BACKFLOW ASSY.  DOUBLE CHK VALVE BACKFLOW ASSY DOUBLE DETECTOR CHECK VALVE QUICK CLOSING FUSIBLE LINK VALVE QUICK OPENING VALVE
LINE LINE  THE SR A 44 F F F F F F F F F F F F F F F F F	ELBOW LONG RADIUS ELBOW SHORT RADIUS ELBOW  45° ELBOW  TEE CROSS LATERAL TEE - SINGLE SWEEP  GATE VALVE ANGLE GATE VALVE BALL VALVE LOCKABLE BALL VALVE BUTTERFLY VALVE GLOBE VALVE ANGLE GLOBE VALVE PLUG VALVE DIAPHRAGM VALVE UALVE IN VERTICAL LINE HOSE GATE VALVE		ELBOW - DOUBLE BRANCH ELBOW - SIDE OUTLET UP ELBOW - SIDE OUTLET DOWN ELBOW - OUTLET DOWN ELBOW - OUTLET UP TEE - OUTLET DOWN TEE - OUTLET UP TEE - SIDE OUTLET DOWN TEE - SIDE OUTLET UP SIAMESE CONNECTION  VALVES  STOP/CHECK GATE VALVE (ARROW IND. FLOW) SPRING GATE CHECK VALVE (ARROW IND. FLOW) ANGLE STOP/CHECK VALVE 2-WAY ELECTROMOTOR VALVE 2-WAY MANUAL VALVE 3-WAY AIRMOTOR VALVE 3-WAY AIRMOTOR VALVE 3-WAY MANUAL VALVE SAFETY PRESSURE RELIEF VALVE PRESSURE RELIEF VALVE	LINE LINE LINE LINE LINE LINE LINE LINE	REDUCER - CONCENTRIC REDUCER - ECCENTRIC CAPPED CONNECTION THREADED CONNECTION STRAINER STRAINER WITH BALL VALVE DR STRAINER WITH COUPLER BUSHING FLOW DIRECTION  MULTIPURPOSE VALVE PRESSURE REDUCING VALVE REDUCED PRESS. BACKFLOW ASSY. DOUBLE CHK VALVE BACKFLOW ASSY DOUBLE DETECTOR CHECK VALVE QUICK CLOSING FUSIBLE LINK VALVE QUICK OPENING VALVE PRESSURE GAUGE & BALL VALVE
LINE LINE  FOR A 44 F F F F F F F F F F F F F F F F F	ELBOW LONG RADIUS ELBOW SHORT RADIUS ELBOW  45° ELBOW  TEE CROSS LATERAL TEE - SINGLE SWEEP  GATE VALVE ANGLE GATE VALVE BALL VALVE LOCKABLE BALL VALVE BUTTERFLY VALVE GLOBE VALVE ANGLE GLOBE VALVE DIAPHRAGM VALVE DIAPHRAGM ACTUATED VALVE VALVE IN VERTICAL LINE HOSE GLOBE VALVE HOSE GLOBE VALVE		ELBOW - DOUBLE BRANCH ELBOW - SIDE OUTLET UP ELBOW - SIDE OUTLET DOWN ELBOW - OUTLET DOWN ELBOW - OUTLET DOWN ELBOW - OUTLET UP TEE - OUTLET DOWN TEE - OUTLET UP TEE - SIDE OUTLET DOWN TEE - SIDE OUTLET DOWN TEE - SIDE OUTLET UP SIAMESE CONNECTION  VALVES  STOP/CHECK GATE VALVE (ARROW IND. FLOW) SPRING GATE CHECK VALVE (ARROW IND. FLOW) ANGLE STOP/CHECK VALVE 2-WAY ELECTROMOTOR VALVE 2-WAY AIRMOTOR VALVE 3-WAY AIRMOTOR VALVE 3-WAY AIRMOTOR VALVE 3-WAY AIRMOTOR VALVE 3-WAY MANUAL VALVE SAFETY PRESSURE RELIEF VALVE PRESSURE RELIEF VALVE TEMPERATURE MIXING VALVE	LINE LINE LINE LINE LINE LINE LINE LINE	REDUCER - CONCENTRIC REDUCER - ECCENTRIC CAPPED CONNECTION THREADED CONNECTION STRAINER STRAINER WITH BALL VALVE DR STRAINER WITH COUPLER BUSHING FLOW DIRECTION  MULTIPURPOSE VALVE PRESSURE REDUCING VALVE PRESSURE REDUCING PILOT VALVE REDUCED PRESS. BACKFLOW ASSY. DOUBLE CHK VALVE BACKFLOW ASSY DOUBLE DETECTOR CHECK VALVE QUICK CLOSING FUSIBLE LINK VALVE QUICK OPENING VALVE PRESSURE GAUGE & BALL VALVE GATE VALVE WITH GLOBE VALVE BY-
LINE LINE  FOR A 44 F F F F F F F F F F F F F F F F F	ELBOW LONG RADIUS ELBOW SHORT RADIUS ELBOW  45° ELBOW  TEE CROSS LATERAL TEE - SINGLE SWEEP  GATE VALVE ANGLE GATE VALVE BALL VALVE LOCKABLE BALL VALVE BUTTERFLY VALVE GLOBE VALVE ANGLE GLOBE VALVE PLUG VALVE DIAPHRAGM VALVE UALVE IN VERTICAL LINE HOSE GATE VALVE		ELBOW - DOUBLE BRANCH ELBOW - SIDE OUTLET UP ELBOW - SIDE OUTLET DOWN ELBOW - OUTLET DOWN ELBOW - OUTLET UP TEE - OUTLET UP TEE - OUTLET UP TEE - SIDE OUTLET DOWN TEE - SIDE OUTLET UP SIAMESE CONNECTION  VALVES  STOP/CHECK GATE VALVE (ARROW IND. FLOW) SPRING GATE CHECK VALVE (ARROW IND. FLOW) ANGLE STOP/CHECK VALVE 2-WAY ELECTROMOTOR VALVE 2-WAY AIRMOTOR VALVE 3-WAY AIRMOTOR VALVE 3-WAY AIRMOTOR VALVE 3-WAY AIRMOTOR VALVE 3-WAY MANUAL VALVE SAFETY PRESSURE RELIEF VALVE PRESSURE RELIEF VALVE TEMPERATURE MIXING VALVE AUTO FLOW VALVE		REDUCER - CONCENTRIC REDUCER - ECCENTRIC CAPPED CONNECTION THREADED CONNECTION STRAINER STRAINER WITH BALL VALVE DR STRAINER WITH COUPLER BUSHING FLOW DIRECTION  MULTIPURPOSE VALVE PRESSURE REDUCING VALVE REDUCED PRESS. BACKFLOW ASSY. DOUBLE CHK VALVE BACKFLOW ASSY DOUBLE DETECTOR CHECK VALVE QUICK CLOSING FUSIBLE LINK VALVE QUICK OPENING VALVE PRESSURE GAUGE & BALL VALVE GATE VALVE WITH GLOBE VALVE BY-ING GLOBE VALVE BY-ING GLOBE VALVE BY-ING CONTENTS TO THE CONTENTS TO TH
LINE LINE  FOR A 44 F F F F F F F F F F F F F F F F F	ELBOW LONG RADIUS ELBOW SHORT RADIUS ELBOW  45° ELBOW  TEE CROSS LATERAL TEE - SINGLE SWEEP  GATE VALVE ANGLE GATE VALVE BALL VALVE LOCKABLE BALL VALVE BUTTERFLY VALVE GLOBE VALVE ANGLE GLOBE VALVE DIAPHRAGM VALVE DIAPHRAGM ACTUATED VALVE VALVE IN VERTICAL LINE HOSE GLOBE VALVE HOSE GLOBE VALVE		ELBOW - DOUBLE BRANCH ELBOW - SIDE OUTLET UP ELBOW - SIDE OUTLET DOWN ELBOW - OUTLET DOWN ELBOW - OUTLET DOWN ELBOW - OUTLET UP TEE - OUTLET DOWN TEE - OUTLET UP TEE - SIDE OUTLET DOWN TEE - SIDE OUTLET DOWN TEE - SIDE OUTLET UP SIAMESE CONNECTION  VALVES  STOP/CHECK GATE VALVE (ARROW IND. FLOW) SPRING GATE CHECK VALVE (ARROW IND. FLOW) ANGLE STOP/CHECK VALVE 2-WAY ELECTROMOTOR VALVE 2-WAY AIRMOTOR VALVE 3-WAY AIRMOTOR VALVE 3-WAY AIRMOTOR VALVE 3-WAY AIRMOTOR VALVE 3-WAY MANUAL VALVE SAFETY PRESSURE RELIEF VALVE PRESSURE RELIEF VALVE TEMPERATURE MIXING VALVE		REDUCER - CONCENTRIC REDUCER - ECCENTRIC CAPPED CONNECTION THREADED CONNECTION STRAINER STRAINER WITH BALL VALVE DR STRAINER WITH COUPLER BUSHING FLOW DIRECTION  MULTIPURPOSE VALVE PRESSURE REDUCING VALVE REDUCED PRESS. BACKFLOW ASSY. DOUBLE CHK VALVE BACKFLOW ASSY DOUBLE DETECTOR CHECK VALVE QUICK CLOSING FUSIBLE LINK VALVE QUICK OPENING VALVE PRESSURE GAUGE & BALL VALVE GATE VALVE WITH GLOBE VALVE BY GLOBE VALVE WITH GLOBE VALVE BY SPRINKLER - CONCEALED
LINE LINE  FOR A 44 F F F F F F F F F F F F F F F F F	ELBOW LONG RADIUS ELBOW SHORT RADIUS ELBOW  45° ELBOW  TEE CROSS LATERAL TEE - SINGLE SWEEP  GATE VALVE ANGLE GATE VALVE BALL VALVE LOCKABLE BALL VALVE BUTTERFLY VALVE GLOBE VALVE ANGLE GLOBE VALVE  PLUG VALVE DIAPHRAGM ACTUATED VALVE VALVE IN VERTICAL LINE HOSE GATE VALVE HOSE GLOBE VALVE HOSE ANGLE VALVE		ELBOW - DOUBLE BRANCH ELBOW - SIDE OUTLET UP ELBOW - SIDE OUTLET DOWN ELBOW - OUTLET DOWN ELBOW - OUTLET DOWN ELBOW - OUTLET UP TEE - OUTLET DOWN TEE - OUTLET UP TEE - SIDE OUTLET DOWN TEE - SIDE OUTLET UP SIAMESE CONNECTION  VALVES  STOP/CHECK GATE VALVE (ARROW IND. FLOW) SPRING GATE CHECK VALVE (ARROW IND. FLOW) ANGLE STOP/CHECK VALVE 2-WAY ELECTROMOTOR VALVE 2-WAY AIRMOTOR VALVE 3-WAY ELECTROMOTOR VALVE 3-WAY AIRMOTOR VALVE 3-WAY AIRMOTOR VALVE 3-WAY AIRMOTOR VALVE TEMPERATURE MIXING VALVE TEMPERATURE MIXING VALVE AUTO FLOW VALVE FLOAT VALVE LOCK SHIELD	LINE LINE LINE LINE LINE LINE LINE LINE	REDUCER - CONCENTRIC  REDUCER - ECCENTRIC  CAPPED CONNECTION THREADED CONNECTION THREADED CONNECTION STRAINER STRAINER WITH BALL VALVE DR STRAINER WITH COUPLER BUSHING FLOW DIRECTION  MULTIPURPOSE VALVE PRESSURE REDUCING VALVE REDUCED PRESS. BACKFLOW ASSY.  DOUBLE CHK VALVE BACKFLOW ASSY  DOUBLE DETECTOR CHECK VALVE QUICK CLOSING FUSIBLE LINK VALVE QUICK OPENING VALVE PRESSURE GAUGE & BALL VALVE GATE VALVE WITH GLOBE VALVE BY SPRINKLER - CONCEALED SPRINKLER - RECESSED
	ELBOW LONG RADIUS ELBOW SHORT RADIUS ELBOW  45° ELBOW  TEE CROSS LATERAL TEE - SINGLE SWEEP  GATE VALVE ANGLE GATE VALVE BALL VALVE LOCKABLE BALL VALVE BUTTERFLY VALVE GLOBE VALVE ANGLE GLOBE VALVE DIAPHRAGM VALVE DIAPHRAGM ACTUATED VALVE VALVE IN VERTICAL LINE HOSE GATE VALVE HOSE GLOBE VALVE SOLENOID VALVE		ELBOW - DOUBLE BRANCH ELBOW - SIDE OUTLET UP ELBOW - SIDE OUTLET DOWN ELBOW - OUTLET DOWN ELBOW - OUTLET DOWN ELBOW - OUTLET DOWN ELBOW - OUTLET DOWN TEE - OUTLET DOWN TEE - SIDE OUTLET DOWN TEE - SIDE OUTLET DOWN TEE - SIDE OUTLET UP SIAMESE CONNECTION  VALVES  STOP/CHECK GATE VALVE (ARROW IND. FLOW) SPRING GATE CHECK VALVE (ARROW IND. FLOW) ANGLE STOP/CHECK VALVE 2-WAY ELECTROMOTOR VALVE 2-WAY AIRMOTOR VALVE 3-WAY AIRMOTOR VALVE 3-WAY AIRMOTOR VALVE 3-WAY AIRMOTOR VALVE 3-WAY AIRMOTOR VALVE TEMPERATURE MIXING VALVE AUTO FLOW VALVE FLOAT VALVE LOCK SHIELD CIRCUIT SETTER		REDUCER - CONCENTRIC  REDUCER - ECCENTRIC  CAPPED CONNECTION THREADED CONNECTION THREADED CONNECTION STRAINER STRAINER WITH BALL VALVE DR STRAINER WITH COUPLER BUSHING FLOW DIRECTION  MULTIPURPOSE VALVE PRESSURE REDUCING VALVE REDUCED PRESS. BACKFLOW ASSY.  DOUBLE CHK VALVE BACKFLOW ASSY DOUBLE DETECTOR CHECK VALVE OUTSIDE STEM & YOKE VALVE QUICK CLOSING FUSIBLE LINK VALVE QUICK OPENING VALVE PRESSURE GAUGE & BALL VALVE GATE VALVE WITH GLOBE VALVE BY-I GLOBE VALVE WITH GLOBE VALVE BY-I GLOBE VALVE WITH GLOBE VALVE BY-I SPRINKLER - CONCEALED SPRINKLER - RECESSED SPRINKLER - SIDEWALL
	ELBOW LONG RADIUS ELBOW SHORT RADIUS ELBOW  45° ELBOW  TEE CROSS LATERAL TEE - SINGLE SWEEP  GATE VALVE ANGLE GATE VALVE BALL VALVE LOCKABLE BALL VALVE BUTTERFLY VALVE GLOBE VALVE ANGLE GLOBE VALVE DIAPHRAGM VALVE DIAPHRAGM ACTUATED VALVE VALVE IN VERTICAL LINE HOSE GATE VALVE HOSE GLOBE VALVE SOLENOID VALVE		ELBOW - DOUBLE BRANCH ELBOW - SIDE OUTLET UP ELBOW - SIDE OUTLET DOWN ELBOW - OUTLET DOWN ELBOW - OUTLET DOWN ELBOW - OUTLET UP TEE - OUTLET DOWN TEE - OUTLET UP TEE - SIDE OUTLET DOWN TEE - SIDE OUTLET UP SIAMESE CONNECTION  VALVES  STOP/CHECK GATE VALVE (ARROW IND. FLOW) SPRING GATE CHECK VALVE (ARROW IND. FLOW) ANGLE STOP/CHECK VALVE 2-WAY ELECTROMOTOR VALVE 2-WAY AIRMOTOR VALVE 3-WAY ELECTROMOTOR VALVE 3-WAY AIRMOTOR VALVE 3-WAY AIRMOTOR VALVE 3-WAY AIRMOTOR VALVE TEMPERATURE MIXING VALVE TEMPERATURE MIXING VALVE AUTO FLOW VALVE FLOAT VALVE LOCK SHIELD	LINE LINE LINE LINE LINE LINE LINE LINE	REDUCER - CONCENTRIC  REDUCER - ECCENTRIC  CAPPED CONNECTION THREADED CONNECTION STRAINER STRAINER WITH BALL VALVE DR STRAINER WITH COUPLER BUSHING FLOW DIRECTION  MULTIPURPOSE VALVE PRESSURE REDUCING VALVE PRESSURE REDUCING PILOT VALVE REDUCED PRESS. BACKFLOW ASSY.  DOUBLE CHK VALVE BACKFLOW ASSY  DOUBLE DETECTOR CHECK VALVE QUICK CLOSING FUSIBLE LINK VALVE QUICK OPENING VALVE PRESSURE GAUGE & BALL VALVE GATE VALVE WITH GLOBE VALVE BY SPRINKLER - CONCEALED SPRINKLER - RECESSED SPRINKLER - SIDEWALL SPRINKLER - UPRIGHT

			PLUMBING		
	PIPE REMOVAL	==NPCW=	NON-POTABLE COLD WATER	— P —	TRAP PRIMER
—DCW—	DOMESTIC COLD WATER	=NPHW $=$	NON-POTABLE HOT WATER	—— НВ	HOSE BIBB
<u></u> т	DOMESTIC HOT WATER	=NPSW $=$	NON-POTABLE SOFT WATER	——WH	WALL HYDRANT
==RHW==	DOMESTIC HOT WATER RECIRC.	= PD $=$	PUMPED DISCHARGE	$\longrightarrow$ RH	ROOF HYDRANT
DSW	DOMESTIC SOFT WATER	<b>=</b> G (XX) <b>=</b>	NATURAL GAS (PSIG)	CO	CLEAN OUT
SAN	SANITARY	= PG (XX) $=$	PROPANE GAS (PSIG)	OFCO	FLOOR CLEAN OUT
ST	STORM	v	VENT	⊙ FD	FLOOR DRAIN
so	STORM OVERFLOW	AW	ACID WASTE	(X) VTR	VENT THRU ROOF (X DENOTES IDENTIFICATION)
=== GW ===	GREASE WASTE	==== AV ====	ACID VENT	(o) RD	ROOF DRAIN
CA	COMPRESSED AIR	==osw $==$	OIL/SAND	(o) ORD	OVERFLOW ROOF DRAIN
PA	PROCESSED AIR	=== IR ===	IRRIGATION	→ DSN	DOWNSPOUT NOZZLE
		М	ISCELLANEOUS		
$\langle \overline{XX} \rangle$	EQUIPMENT IDENTIFICATION TAG (ELECTRICAL CONNECTION REQUIRED)	•	NEW CONNECTION POINT	WC	WATER CLOSET
_	DETAIL REFERENCE		POINT OF DISCONNECT	UR	URINAL
XX	SHEET REFERENCE	OA	OUTSIDE AIR	L	LAVATORY
	OFOTION OUT DEFENSE	VA	VENTILATION AIR	S	SINK
$\begin{array}{ c c c c c c c c c c c c c c c c c c c$	SECTION CUT REFERENCE SHEET REFERENCE	EA	EXHAUST AIR	DF	DRINKING FOUNTAIN
		RA	RELIEF OR RETURN AIR	EWC	ELECTRIC WATER COOLER
	ELECTRICAL PANEL - SHOWN FOR COORDINATION PURPOSES ONLY	SA	SUPPLY AIR	SS	SERVICE SINK
	ELECTRICAL PANEL - SHOWN FOR	MA	MIXED AIR	SH	SHOWER
	COORDINATION PURPOSES ONLY	RF	RELIEF OR RETURN FAN	DWH	DOMESTIC WATER HEATER
	ELECTRICAL PANEL - SHOWN FOR	EF	EXHAUST FAN	MSB	MOP SINK BASIN
	COORDINATION PURPOSES ONLY	DCE	DUST COLLECTION EXHAUST	(5)	DASHED DARK LINEWORK = DEMOLITION
T	ELECTRICAL TRANSFORMER - SHOWN FOR COORDINATION PURPOSES ONLY	(TYP)	TYPICAL	(E)	LIGHT LINEWORK = EXISTING  DARK LINEWORK = NEW

NOTICE: DO NOT SCALE DRAWINGS. VERIFY ALL DIMENSIONS AND CLEARANCES FROM ARCHITECTURAL, STRUCTURAL, SHOP AND OTHER APPROPRIATE DRAWINGS OR AT SITE. LAY OUT AND COORDINATE ALL WORK PRIOR TO INSTALLATION TO PROVIDE CLEARANCES REQUIRED FOR OPERATION, MAINTENANCE, AND CODES. VERIFY NON-INTERFERENCE WITH OTHER WORK. DO NOT FABRICATE PRIOR TO VERIFICATION OF CLEARANCES FOR ALL TRADES. THIS NOTICE APPLIES TO ALL MECHANICAL / PLUMBING PLANS.

	MECHANICAL					
Sheet Number	Sheet Name					
MECHANICAL						
M0.0	MECHANICAL SYMBOLS LEGEND AND GENERAL NOTES					
M0.1	NORTH MECHANICAL KEY PLAN					
M0.2	NORTHWEST MECHANICAL KEY PLAN					
M0.3	NORTH MECHANICAL DEMOLITION PLAN					
M0.4	NORTHWEST MECHANICAL DEMOLITION PLAN					
M1.1	NORTH MECHANICAL PLAN					
M1.2	NORTHWEST MECHANICAL PLAN					
M7.1	MECHANICAL DETAILS AND SCHEDULES					
Grand total: 8						

### GENERAL MECHANICAL / PLUMBING

### **DEMOLITION NOTES**

APPLY TO ALL MECHANICAL AND PLUMBING SHEETS

- ALL EXISTING ITEMS AND ASSOCIATED PIPING, ACCESSORIES, SUPPORTS AND HANGERS INDICATED BY BOLD, DASHED, HEAVY LINES OR IDENTIFIED BY NOTES, SHALL BE COMPLETELY REMOVED. PRIOR TO PROPER DISPOSAL OF REMOVED ITEMS, OWNER SHALL HAVE FIRST RIGHT OF REFUSAL
- DRAWINGS INDICATE APPROXIMATE ROUTING OF PIPING, DUCTWORK AND MAJOR COMPONENTS AND DO NOT INCLUDE ALL OFFSETS, FITTINGS, VALVES, ETC. CONTRACTOR SHALL FIELD VERIFY EXACT SIZE AND ROUTING PRIOR TO REMOVAL OR RELOCATION. CONTRACTOR SHALL ALSO BE RESPONSIBLE FOR REMOVAL OF MISCELLANEOUS MECHANICAL ITEMS LOCATED ON OR IN ANY WALLS TO BE REMOVED.
- EXISTING INSULATION DAMAGED DURING DEMOLITION / CONSTRUCTION ACTIVITIES SHALL BE REPAIRED WITH SIMILAR MATERIALS.
- ALL OPENINGS THROUGH WALLS AND FLOOR SLABS NOT BEING REUSED SHALL BE PATCHED WITH LIKE MATERIALS AND PAINTED TO MATCH EXISTING.
- ALL OPENINGS THROUGH ROOF NOT BEING REUSED SHALL BE PATCHED WITH LIKE MATERIALS AND SEALED WATERTIGHT.
- CONTRACTOR SHALL REMOVE ALL MATERIALS AS REQUIRED AND SHALL GIVE OWNER THE OPPORTUNITY TO INSPECT SUCH MATERIALS FOR POTENTIAL SALVAGE. CONTRACTOR SHALL REMOVE FROM THE SITE ALL MATERIALS DEEMED "NON-SALVAGEABLE" BY THE OWNER. CONTRACTOR SHALL TURN OVER TO OWNER ALL MATERIALS DEEMED "SALVAGEABLE" BY THE OWNER.

### GENERAL MECHANICAL NOTES

### APPLY TO ALL MECHANICAL SHEETS

- LIGHT LINE WEIGHT INDICATES EXISTING ITEMS AND ASSOCIATED MATERIALS TO REMAIN. BOLD LINE WEIGHT INDICATES NEW WORK TO BE INSTALLED UNDER THIS CONTRACT. ROUTING INDICATED ON DRAWINGS IS APPROXIMATE AND DOES NOT INCLUDE ALL OFFSETS, FITTINGS, VALVES, ETC. CONTRACTOR TO FIELD VERIFY DUCT SIZE AND SERVICE PRIOR TO FINAL CONNECTION. COORDINATE LOCATION OF HVAC WORK WITH LIGHTING, STRUCTURAL MEMBERS, PIPING SYSTEMS, ETC. PROVIDE OFFSETS AND CLEARANCES OR RELOCATE HVAC WORK AS REQUIRED TO AVOID CONFLICTS WITH WORK OF ALL OTHER
- HVAC WORK SHALL NOT BE LOCATED OVER ELECTRICAL, DATA, OR COMMUNICATION EQUIPMENT ROOMS. HVAC WORK SHALL NOT BE LOCATED ABOVE ELECTRICAL / DATA / COMMUNICATION EQUIPMENT OR PANELS.
- SUPPORT ALL DUCTWORK, PIPING, EQUIPMENT, ETC. FROM BUILDING STRUCTURE. HOLD PIPING TIGHT TO BOTTOM OF STRUCTURAL MEMBERS OR RUN THROUGH JOIST WEBS IF POSSIBLE. DO NOT USE WIRE OR PERFORATED METAL TO SUPPORT PIPING. DO NOT SUPPORT PIPING FROM OTHER PIPING, DUCTWORK AND/OR ELECTRICAL CONDUITS. DO NOT SUPPORT FROM BOTTOM OF CHORD OF BAR JOIST OR FROM METAL ROOF DECK.
- ALL DUCT SIZES SHOWN ARE CLEAR AIRWAY DIMENSIONS. INCREASE SHEET METAL SIZE TO ACCOMMODATE DUCT LINER AS REQUIRED. ELBOWS SHALL BE CONSTRUCTED WITH CENTERLINE RADIUS OF NOT LESS THAN 1-1/2
- TIMES THE WIDTH OF DUCT. WHERE SPACE CONDITIONS DO NOT PERMIT THIS RADIUS OR WHERE INDICATED ON DRAWINGS SQUARE ELBOWS WITH TURNING VANES SHALL BE USED. SIZE TRANSITIONS WITH A MINIMUM SLOPE OF 1:4. PROVIDE DRAW BANDS AND SEAL END OF DUCT INSULATION ON ALL FLEXIBLE
- CONNECTIONS. MAXIMUM LENGTH OF FLEXIBLE DUCTS SHALL BE THREE FEET. CONTRACTOR SHALL BE RESPONSIBLE FOR PROPERLY SEALING PENETRATIONS THROUGH A FIRE RATED, SMOKE RATED OR COMBINATION FIRE & SMOKE RATED SEPARATIONS. SEE SPECIFICATIONS FOR FIRE & SMOKE RATED SEALANTS. SEE ARCHITECTURAL PLANS FOR
- COORDINATE ALL GRILLE, REGISTER AND DIFFUSER LOCATIONS WITH REFLECTED CEILING PLAN, LIGHT FIXTURES, SPRINKLER HEADS, COMMUNICATION/SOUND DEVICES AND FIRE ALARM DEVICES. INSTALL ESCUTCHEON PLATES ON ALL WALL PENETRATIONS SERVING ROUND DUCT WALL
- PENETRATIONS. FABRICATE ESCUTCHEON PLATES TO TRIM THE OPENING IN THE WALL. INSTALL WALL ANGLE FOR ALL RECTANGULAR DUCT PENETRATIONS THROUGH WALLS. FOR EXPOSED DUCTWORK THOROUGHLY CLEAN, REMOVE ALL SHIPPING LABELS AND OTHER IDENTIFICATION TAGS. DUCTWORK DESIGNATED TO BE PAINTED SHALL HAVE PHOSPHATIZED FINISH. PROVIDE MILL-PHOSPHATIZED FINISH FOR EXPOSED NOT DESIGNATED TO BE PAINTED. COORDINATE WITH ARCHITECTURAL DRAWINGS DUCTWORK
- DESIGNATED FOR PAINTING AND EXPOSED DUCTWORK REQUIREMENTS. PROVIDE DUCT MOUNTED ACCESS DOOR AT FIRE DAMPER, SMOKE DAMPER OR COMBINATION FIRE/SMOKE DAMPERS TO ALLOW FOR MAINTENANCE AND VISUAL INSPECTION PER NFPA REQUIREMENTS.
- VOLUME DAMPERS ABOVE INACCESSIBLE CEILINGS SHALL HAVE EXTENSION RODS AND ESCUTCHEON PLATES. LOCATE AND INSTALL EQUIPMENT TO PROVIDE ALL CODE AND MANUFACTURER'S
- RECOMMENDED CLEARANCES. KEEP HVAC PIPING, DUCTWORK, ETC. OUT OF CLEARANCE
- ALL OPENINGS IN WALLS AND FLOORS FOR PIPING SHALL BE CORE DRILLED OR SAW CUT, UNLESS OTHERWISE NOTED. ALL HVAC PIPING WORK SHALL BE LOCATED ABOVE CEILINGS, IN A PIPE CHASE, OR OTHER CONCEALED LOCATIONS, UNLESS OTHERWISE NOTED. LOCATE AND ARRANGE VALVES,

DRAIN FITTINGS, ETC. TO BE ACCESSIBLE THROUGH LAY-IN CEILINGS, ACCESS PANELS OR ACCESS DOORS. PROVIDE ACCESS PANEL OR ACCESS DOOR FOR ALL VALVES, DRAIN

- FITTINGS, ETC. AT NON-ACCESSIBLE LOCATIONS. INSTALL SECTIONAL VALVES ON EACH BRANCH AND/OR RISER SERVING TWO OR MORE HYDRONIC TERMINALS OR EQUIPMENT CONNECTIONS. INSTALL VALVES ADJACENT TO
- INSTALL SHUTOFF VALVES ON INLET AND OUTLET OF EACH MECHANICAL EQUIPMENT ITEM AND/OR EACH HYDRONIC TERMINAL.
- SLOPE HVAC PIPING TO DRAIN VALVES. PROVIDE MANUAL AIR VENTS AT HIGH POINTS AND SEAL ALL HVAC PENETRATIONS. SEAL PENETRATIONS THROUGH RATED WALLS, FLOORS OR CEILINGS WITH MATERIALS APPROPRIATE FOR RATING.
- PIPING IN EXTERIOR WALLS SHALL BE LOCATED ON THE INTERIOR SIDE OF BUILDING
- INSULATION AND VAPOR BARRIER.
- COORDINATE INSTALLATION OF BUILDING INSULATION TO RUN CONTINUOUS BETWEEN PIPING AND EXTERIOR WALL SURFACE.
- PVC PIPING SHALL NOT BE INSTALLED IN ANY RETURN AIR PLENUM UNLESS THE PIPING IS INSTALLED IN A PRE-APPROVED RATED ASSEMBLY.
- COORDINATE DUCTWORK WITH STRUCTURAL CROSS BRACING. PROVIDE TOP AND BOTTOM BRIDGING BETWEEN JOISTS WHERE DUCTWORK IS TO BE INSTALLED BETWEEN THE JOISTS. COORDINATE WITH ALL TRADES.

### **GENERAL PLUMBING NOTES**

APPLY TO ALL PLUMBING SHEETS

- LIGHT LINE WEIGHT INDICATES EXISTING ITEMS AND ASSOCIATED MATERIALS TO REMAIN BOLD LINE WEIGHT INDICATES NEW WORK TO BE INSTALLED UNDER THIS CONTRACT. ROUTING INDICATED ON DRAWINGS IS APPROXIMATE AND DOES NOT INCLUDE ALL OFFSETS. FITTINGS, VALVES, ETC. CONTRACTOR TO FIELD VERIFY PIPE SIZE AND SERVICE PRIOR TO FINAL CONNECTION. COORDINATE LOCATION OF PLUMBING PIPING WORK WITH LIGHTING, STRUCTURAL MEMBERS, HVAC, PIPING SYSTEMS, ETC. PROVIDE OFFSETS AND CLEARANCES
- OTHER TRADES. PLUMBING WORK SHALL NOT BE LOCATED OVER ELECTRICAL, DATA OR COMMUNICATION EQUIPMENT ROOMS. PLUMBING WORK SHALL NOT BE LOCATED ABOVE ELECTRICAL / DATA /

OR RELOCATE PLUMBING WORK AS REQUIRED TO AVOID CONFLICTS WITH WORK OF ALL

- COMMUNICATION EQUIPMENT OR PANELS. SUPPORT ALL PLUMBING PIPING, EQUIPMENT, ETC. FROM BUILDING STRUCTURE. HOLD PIPING TIGHT TO BOTTOM OF STRUCTURAL MEMBERS OR RUN THROUGH JOIST WEBS IF POSSIBLE. DO NOT USE WIRE OR PERFORATED METAL TO SUPPORT PIPING. DO NOT SUPPORT PIPING FROM OTHER PIPING, DUCTWORK AND/OR ELECTRICAL CONDUITS. DO NOT SUPPORT FROM BOTTOM OF CHORD OF BAR JOIST OR FROM METAL ROOF DECK.
- ROUTE ABOVE GRADE DRAINAGE PIPING AS HIGH AS POSSIBLE AND COORDINATE WITH OTHER TRADES.
- CONTRACTOR SHALL BE RESPONSIBLE FOR PROPERLY SEALING PENETRATIONS THROUGH A FIRE RATED, SMOKE RATED OR COMBINATION FIRE & SMOKE RATED SEPARATIONS. SEE SPECIFICATIONS FOR FIRE & SMOKE RATED SEALANTS. SEE ARCHITECTURAL PLANS FOR
- INSTALL ESCUTCHEON PLATES ON ALL WALL AND FLOOR PENETRATIONS SERVING EXPOSED PLUMBING PIPING WALL PENETRATIONS.
- ALL OPENINGS IN WALLS AND FLOORS FOR PIPING SHALL BE CORE DRILLED OR SAW CUT, UNLESS OTHERWISE NOTED.
- LOCATE AND INSTALL EQUIPMENT TO PROVIDE ALL CODE AND MANUFACTURER'S RECOMMENDED CLEARANCES. KEEP HVAC PIPING, DUCTWORK, ETC. OUT OF CLEARANCE
- ALL PLUMBING PIPING WORK SHALL BE LOCATED ABOVE CEILINGS, IN A PIPE CHASE, OR OTHER CONCEALED LOCATIONS, UNLESS OTHERWISE NOTED. LOCATE AND ARRANGE VALVES, DRAIN FITTINGS, ETC. TO BE ACCESSIBLE THROUGH LAY-IN CEILINGS, ACCESS PANELS OR ACCESS DOORS. PROVIDE ACCESS PANEL OR ACCESS DOOR FOR ALL VALVES, DRAIN FITTINGS, ETC. AT NON-ACCESSIBLE LOCATIONS.
- INSTALL SECTIONAL VALVES ON EACH BRANCH AND/OR RISER SERVING TWO OR MORE PLUMBING FIXTURES OR EQUIPMENT CONNECTIONS. INSTALL VALVES ADJACENT TO MAIN.
- INSTALL SHUTOFF VALVES ON INLET AND OUTLET OF PLUMBING EQUIPMENT. INSTALL STOPS AT EACH PLUMBING FIXTURE EXCEPT AT FLUSHOMETER LOCATIONS.
- SEAL ALL PLUMBING PIPING PENETRATIONS. SEAL PENETRATIONS THROUGH RATED WALLS, FLOORS OR CEILINGS WITH MATERIALS APPROPRIATE FOR RATING.
- PIPING IN EXTERIOR WALLS SHALL BE LOCATED ON THE INTERIOR SIDE OF BUILDING INSULATION AND VAPOR BARRIER.
- COORDINATE INSTALLATION OF BUILDING INSULATION TO RUN CONTINUOUS BETWEEN PIPING AND EXTERIOR WALL SURFACE. COORDINATE EXACT LOCATION OF FLOOR DRAINS AND FLOOR SINKS. TOP OF GRATE SHALL
- BE 1/8" BELOW FINISHED FLOOR ELEVATION. COMPLY WITH LOCAL UTILITY COMPANY RULES AND REGULATIONS FOR ALL GAS METER INSTALLATIONS. COORDINATE EXACT LOCATION OF GAS CONNECTIONS WITH EQUIPMENT
- COPPER PIPING LOCATED ABOVE GRADE SHALL BE TYPE "L"; COPPER PIPING LOCATED BELOW GRADE SHALL BE TYPE "K" AND RUN CONTINUOUS WITHOUT JOINTS BELOW GRADE. TYPE "M" COPPER SHALL NOT BE USED ON PRESSURIZED PIPING SYSTEMS.
- DRAINAGE PIPING 3 INCHES AND SMALLER SHALL SLOPE NO LESS THAN 1/4 INCH PER FOOT. DRAINAGE PIPING 4 INCHES AND LARGER SHALL SLOPE NO LESS THAN 1/8 INCH PER FOOT.
- INSTALL WALL CLEAN OUTS (WCO) WHEN LOCATED BEHIND A WATER CLOSET AT 30" A.F.F. OR AT 42" A.F.F. ABOVE CABINETRY ON ALL SANITARY & STORM STACKS. COORDINATE EXACT STORM PIPE CONNECTIONS WITH STORM DRAIN LOCATIONS SHOWN ON
- ARCHITECTURAL ROOF PLAN. INSTALL VENT-THRU-ROOF (VTR) A MINIMUM OF 10'-0" AWAY FROM ANY OUTSIDE AIR INTAKE.
- REMOVE, REPAIR AND REPLACE WALLS, FLOORS, ROOFS AND CEILINGS TO MATCH EXISTING, WHERE NECESSARY FOR PIPING AND FIXTURE REMOVAL & INSTALLATION. KITCHEN EQUIPMENT FURNISHED BY KITCHEN EQUIPMENT CONTRACTOR - PLUMBING
- CONTRACTOR SHALL ROUGH-IN AND MAKE FINAL CONNECTIONS TO UTILITIES REQUIRED AND PROVIDE PIPING. STOPS. WATER HAMMER ARRESTERS. TRAPS AND FITTINGS FOR EQUIPMENT TO BE IN OPERATIONAL ORDER. COORDINATE WITH KITCHEN EQUIPMENT SUPPLIER FOR CONNECTIONS AND LOCATIONS. SEE KITCHEN EQUIPMENT CONNECTION SCHEDULE FOR RESPONSIBILITY OF WHO FURNISHES VACUUM BREAKERS AND PRESSURE REDUCING VALVES.
- PVC PIPING SHALL NOT BE INSTALLED IN ANY RETURN AIR PLENUM UNLESS THE PIPING IS INSTALLED IN A PRE-APPROVED RATED ASSEMBLY.
- PROVIDE ACCESSIBLE SHUTOFF VALVE INSIDE THE BUILDING FOR EACH WALL HYDRANT. CONTRACTOR SHALL COORDINATE ALL CONNECTIONS OF PLUMBING SYSTEMS WITH EXTERIOR SITE UTILITIES AND SERVICES PRIOR TO INSTALLING ANY PIPING ON THE INTERIOR CONTRACTOR SHALL CONFIRM THAT ALL INTERIOR PIPE INVERTS AND PIPE INVERTS AT THE 5' LINE MATCH EXTERIOR PIPE INVERTS, PRIOR TO INSTALLING ANY INTERIOR PIPING BELOW

## OPS NORTH & NORTHWEST COOLING TOWER REPLACEMENT


### OMAHA, NE

MECHANICAL SYMBOLS LEGEND AND GENERAL **NOTES** 



COPYRIGHT BDH#: 25023 This document and the information contained may not be reproduced or excerpted from without the express written permission of BDH Engineering, LLC. Unauthorized copying, disclosure or

construction use are prohibited by the copyright law

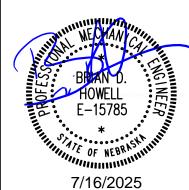

# OPS NORTH & NORTHWEST COOLING TOWER REPLACEMENT


OMAHA, NE

NORTH MECHANICAL KEY PLAN



COPYRIGHT BDH#: 25023

This document and the information contained may not be reproduced or excerpted from without the express written permission of BDH Engineering, LLC. Unauthorized copying, disclosure or construction use are prohibited by the copyright law.

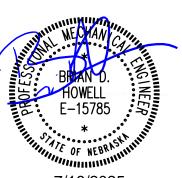


PROJECT: 25023 DATE: 07/16/2025

MO.1

NORTH MECHANICAL KEY PLAN

| SCALE: 1/16" = 1'| 0' 4' 8' 16' 32' 48'

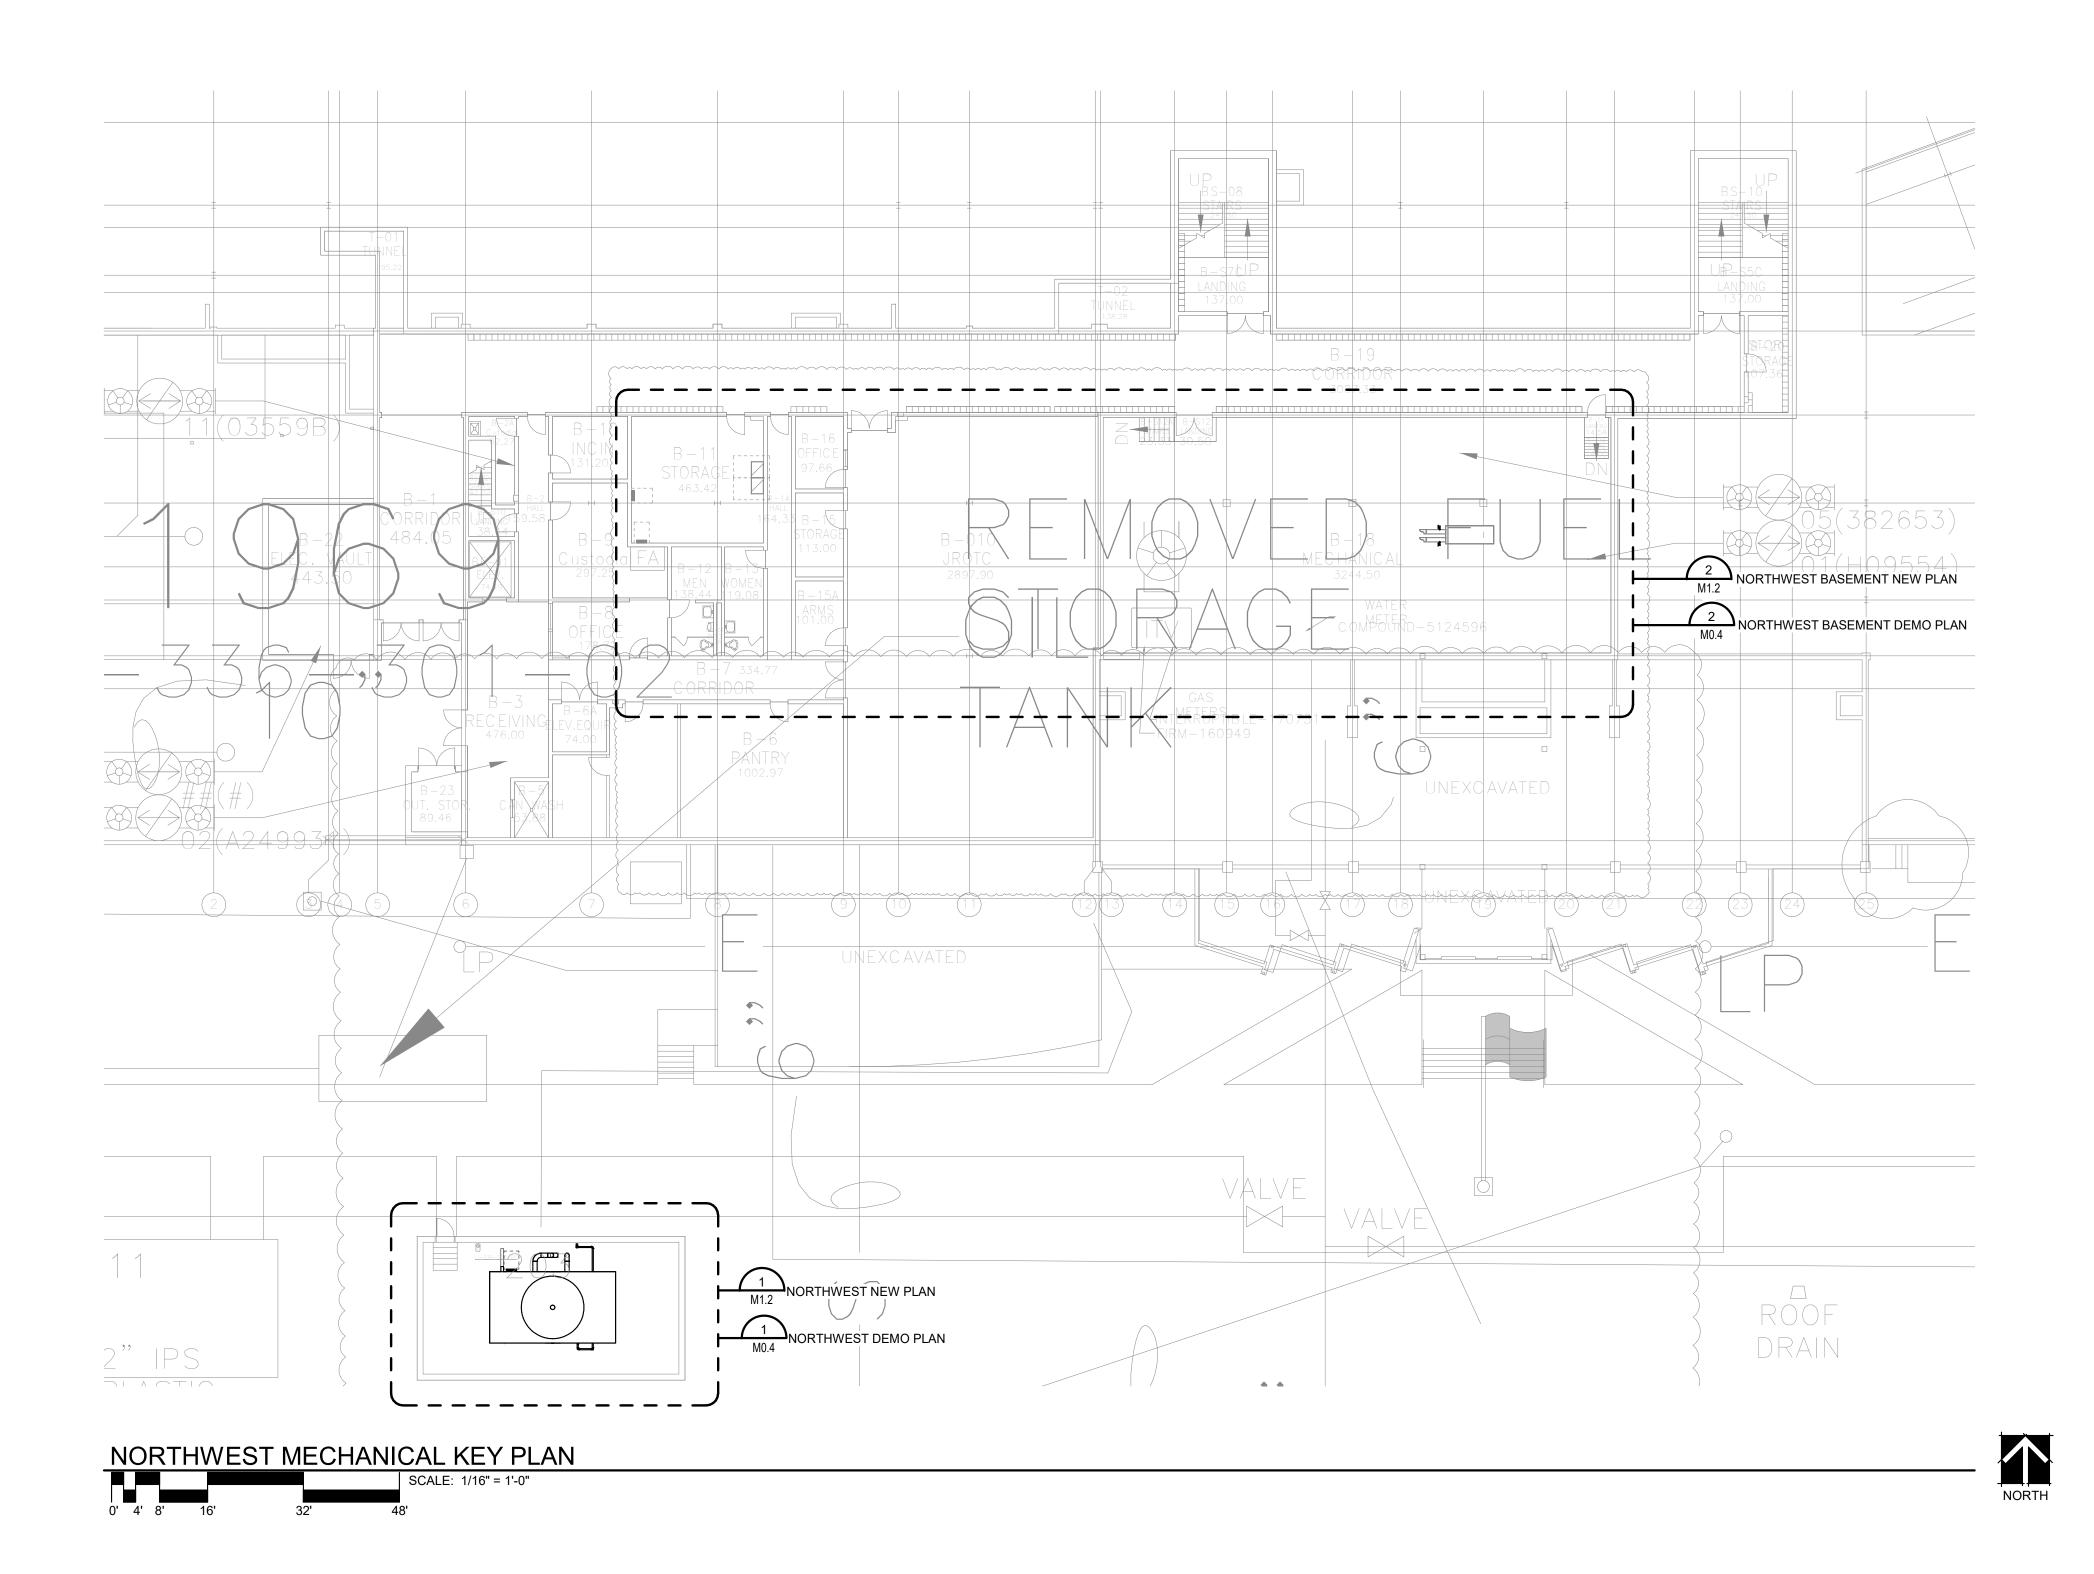


# OPS NORTH & NORTHWEST COOLING TOWER REPLACEMENT

OMAHA, NE

NORTHWEST MECHANICAL KEY PLAN



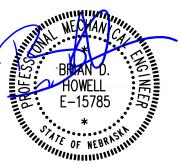


PROJECT:
DATE: 0

ECT: 25023 07/16/2025

M0.2



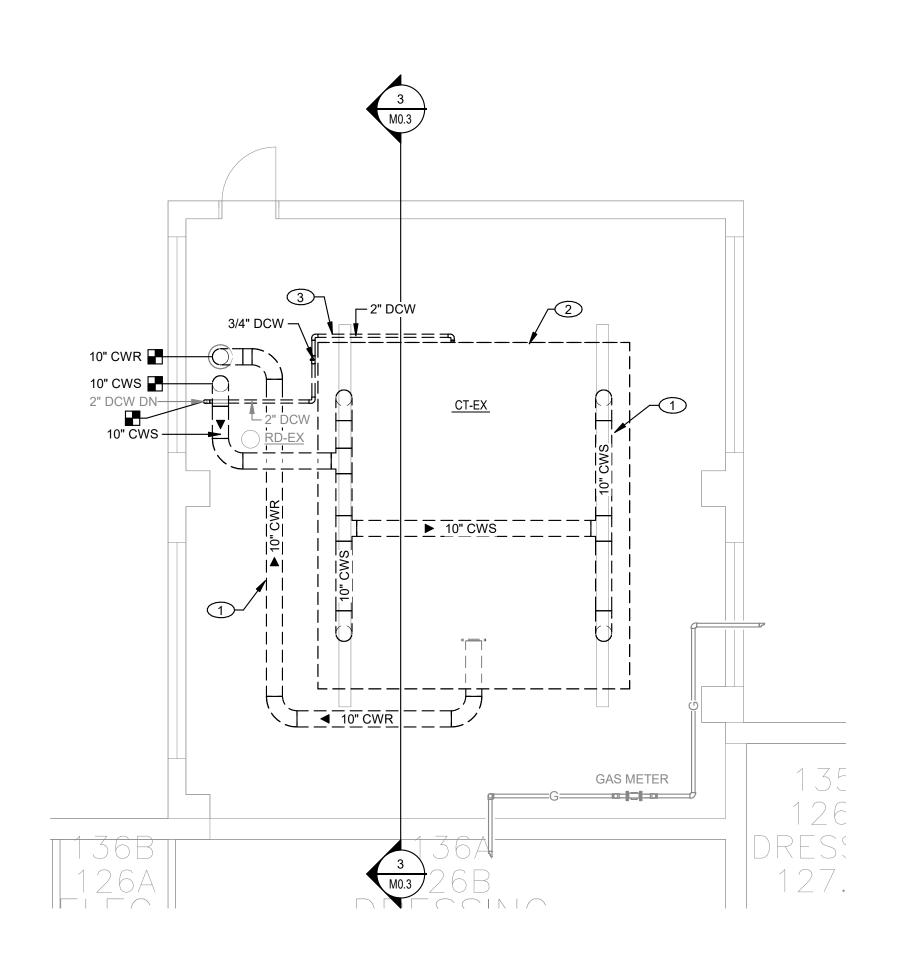



FIRST FLOOR 100' - 0"



### **MECHANICAL DEMOLITION NOTES:**

SEE SHEET M0.0 FOR MECHANICAL SYMBOLS LEGEND AND GENERAL PLUMBING DEMOLITION NOTES.

### **KEYNOTES**

- REMOVE ALL PIPING FROM TOWER TO FLANGE AT GROUND PENETRATION. LOWER TOWER SUPPLY PIPING CONNECTION
- POINT AS LOW AS POSSIBLE.
- REMOVE EXISTING TOWER AND ALL ASSOCIATED COMPONENTS. PREPARE EXISTING CONCRETE SUPPORTS TO ACCEPT NEW STEEL EXTENSION AND NEW TOWER.
- REMOVE MAKE UP WATER BACK TO ISOLATION VALVE. REMOVE ISOLATION VALVE AND PREPARE PIPING FOR NEW
- 4 EXISTING CHILLER TO REMAIN.
- PREPARE CONDENSER WATER PIPING AT CHILLER FOR NEW 1" TAP FOR NEW NO SCALE SYSTEM.

OPS NORTH & NORTHWEST COOLING TOWER REPLACEMENT


OMAHA, NE

NORTH MECHANICAL **DEMOLITION PLAN** 



BDH Engineering
440 Regency Parkway,
Suite 135
Omaha, NE 68114
bdhengineer.com
CA-4258

This document and the information contained may not be reproduced or excerpted from without the express written permission of BDH Engineering, LLC. Unauthorized copying, disclosure or construction use are prohibited by the copyright law.

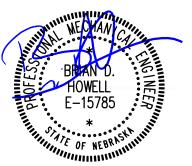

PROJECT: 07/16/2025

25023



10" CWS 10" CWS

CT-EX


10" CWR •

NORTH SCHOOL SECTION AT PIPING DEMOLITION

SCALE: 1/4" = 1'-0"

2




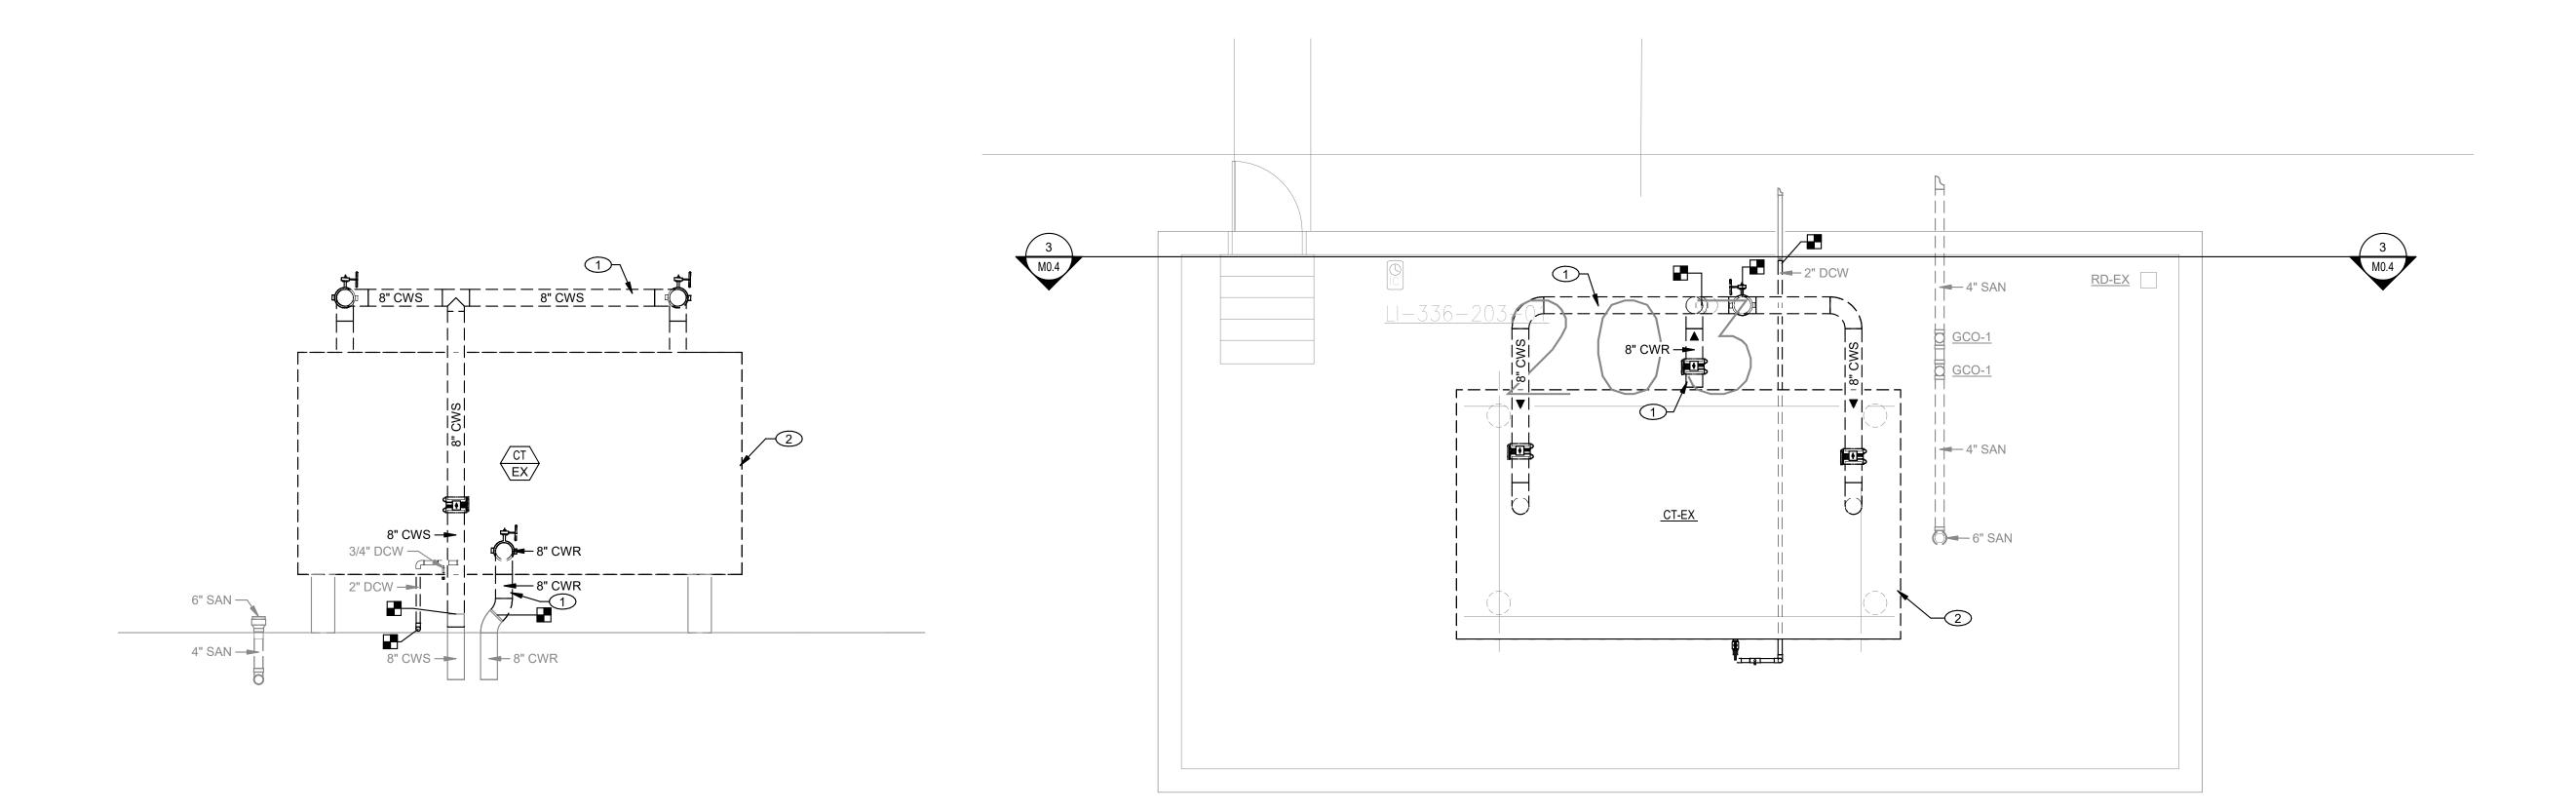

NORTHWEST BASEMENT MECHANICAL DEMOLITION PLAN

SCALE: 1/8" = 1'-0"



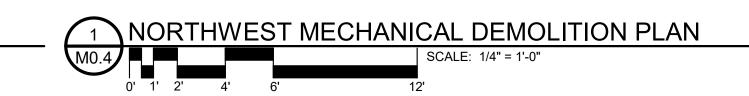



### MECHANICAL DEMOLITION NOTES:

A. SEE SHEET M0.0 FOR MECHANICAL SYMBOLS LEGEND AND GENERAL PLUMBING DEMOLITION NOTES.

### **KEYNOTES**

- 1 REMOVE ALL PIPING FROM TOWER TO FLANGE AT GROUND PENETRATION. LOWER TOWER SUPPLY PIPING CONNECTION POINT AS LOW AS POSSIBLE.
- 2 REMOVE EXISTING TOWER AND ALL ASSOCIATED COMPONENTS. PREPARE EXISTING CONCRETE SUPPORTS TO ACCEPT NEW STEEL EXTENSION AND NEW TOWER.
- 3 PROVIDE 12" TALL W12X26 GALVANIZED BEAM ON EXISTING SUPPORT STRUCTURE. SECURE BEAM TO SUPPORT AND SECURE TOWER TO BEAM.
- PREPARE CONDENSER WATER PIPING AT CHILLER FOR NEW 1" TAP FOR NEW NO SCALE SYSTEM.

OPS NORTH & NORTHWEST COOLING TOWER REPLACEMENT

OMAHA, NE


NORTHWEST MECHANICAL DEMOLITION PLAN



BDH Engineering 440 Regency Parkway, Suite 135 Omaha, NE 68114 bdhengineer.com

COPYRIGHT BDH#: 25023

This document and the information contained may not be reproduced or excerpted from without the express written permission of BDH Engineering, LLC. Unauthorized copying, disclosure or construction use are prohibited by the copyright law.

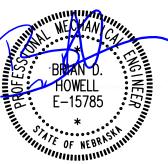

PROJECT:


: 07/16/2025


25023


M0.4





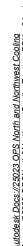

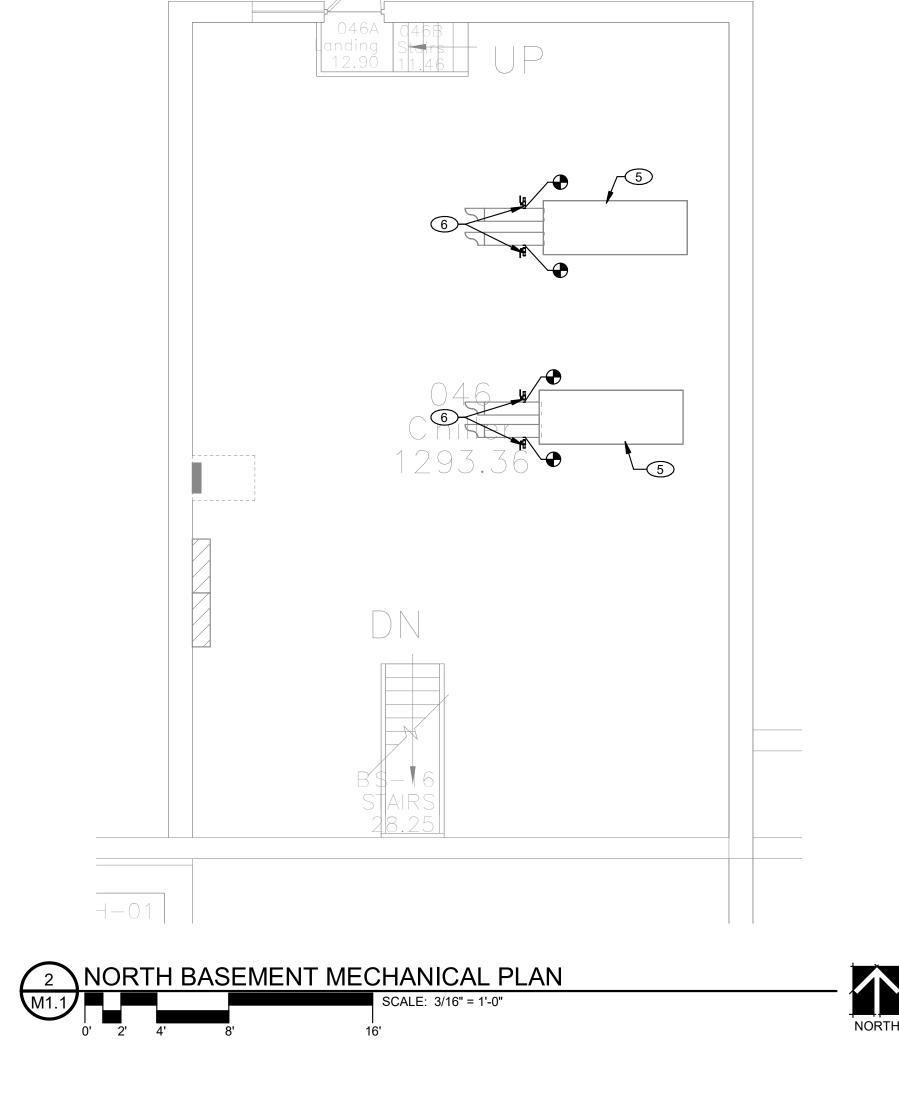

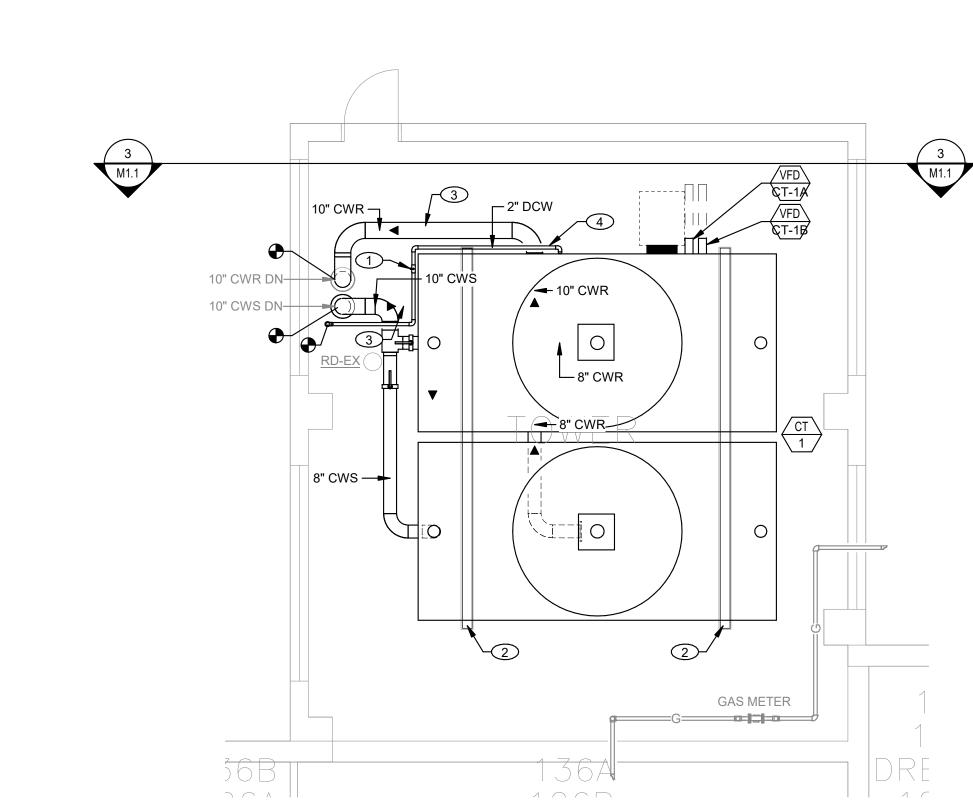



### **MECHANICAL PIPING NOTES:**

- SEE SHEET M0.0 FOR MECHANICAL SYMBOLS LEGEND AND GENERAL MECHANICAL NOTES.
- SUPPORT PIPING FROM STRUCTURE AS REQUIRED. SEE PIPE SUPPORT DETAIL FOR ADDITIONAL INFORMATION.

### **KEYNOTES**

- PROVIDE 3/4" THREADED HOSE CONNECTION WITH BALL VALVE
- FOR ISOLATION. PROVIDE 12" TALL W12X26 GALVANIZED BEAM ON EXISTING
- SUPPORT STRUCTURE. SECURE BEAM TO SUPPORT AND SECURE TOWER TO BEAM. PROVIDE HEAT TRACE ON COOLING TOWER SUPPLY AND
- RETURN PIPING. HEAT TRACE SHALL BE 8 W/FT AND BE DESIGNED TO MAINTAIN THE PIPE AT 38 DEG F WITH AN OUTDOOR TEMPERATURE OF 10 DEG F. INSULATE CONDENSER WATER PIPING OVER THE HEAT TRACE WITH A MINIMUM OF 1-1/2" FIBERGLASS INSULATION AND ALUMINUM JACKETING. PROVIDE HEAT TRACE CONTROL SYSTEM TO AUTOMATICALLY MAINTAIN DESIRED TEMPERATURE. INSTALL HEAT TRACE PER MANUFACTURER RECOMMENDATIONS.
- PROVIDE HEAT TRACE ON MAKE UP WATER PIPING. HEAT TRACE SHALL BE 6 W/FT AND BE DESIGNED TO MAINTAIN THE PIPE AT 38 DEG F WITH AN OUTDOOR TEMPERATURE OF 10 DEG F. INSULATE MAKE UP WATER PIPING OVER THE HEAT TRACE WITH A MINIMUM OF 1-1/2" FIBERGLASS INSULATION AND ALUMINUM JACKETING. PROVIDE HEAT TRACE CONTROL SYSTEM TO AUTOMATICALLY MAINTAIN DESIRED TEMPERATURE. INSTALL HEAT TRACE PER MANUFACTURER RECOMMENDATIONS.
- EXISTING CHILLER TO REMAIN. 6 PROVIDE 1" TAP AND BALL VALVE FOR CONNECTION OF NO SCALE SYSTEM. COORDINATE INSTALLATION WITH INSTALLING CONTRACTOR FOR THAT SYSTEM.

# OPS NORTH & NORTHWEST COOLING




This document and the information contained may not be reproduced or excerpted from without the express written permission of BDH Engineering, LLC. Unauthorized copying, disclosure or construction use are prohibited by the copyright law.



7/16/2025

PROJECT:

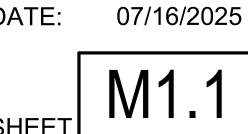

25023

TOWER REPLACEMENT OMAHA, NE NORTH MECHANICAL PLAN

\_\_ 2" DCW

10" CWR → 🚟 →

10" CWR -


FIRST FLOOR 100' - 0"

FOUNDATION 90' - 0"

3 NORTH SCHOOL SECTION AT PIPING


SCALE: 1/4" = 1'-0"



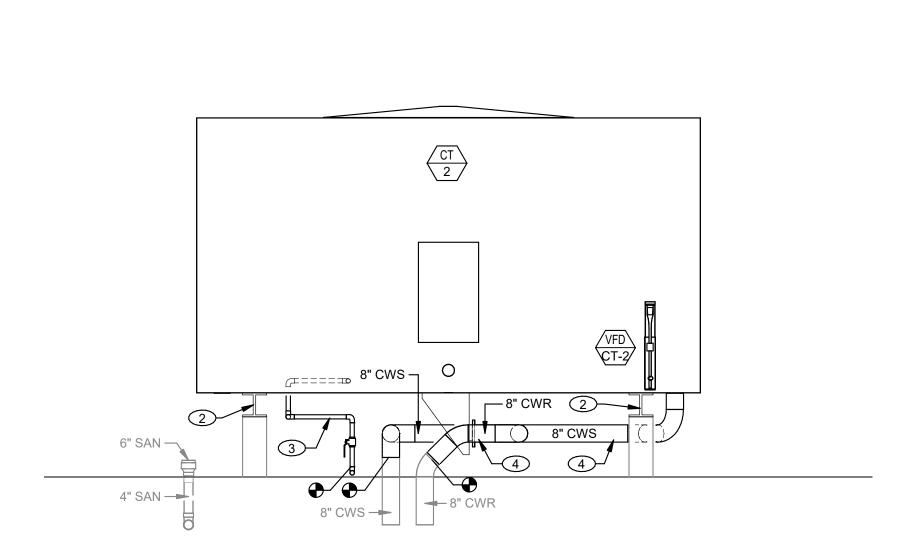

2 NORTHWEST BASEMENT MECHANICAL PLAN

SCALE: 1/8" = 1'-0"

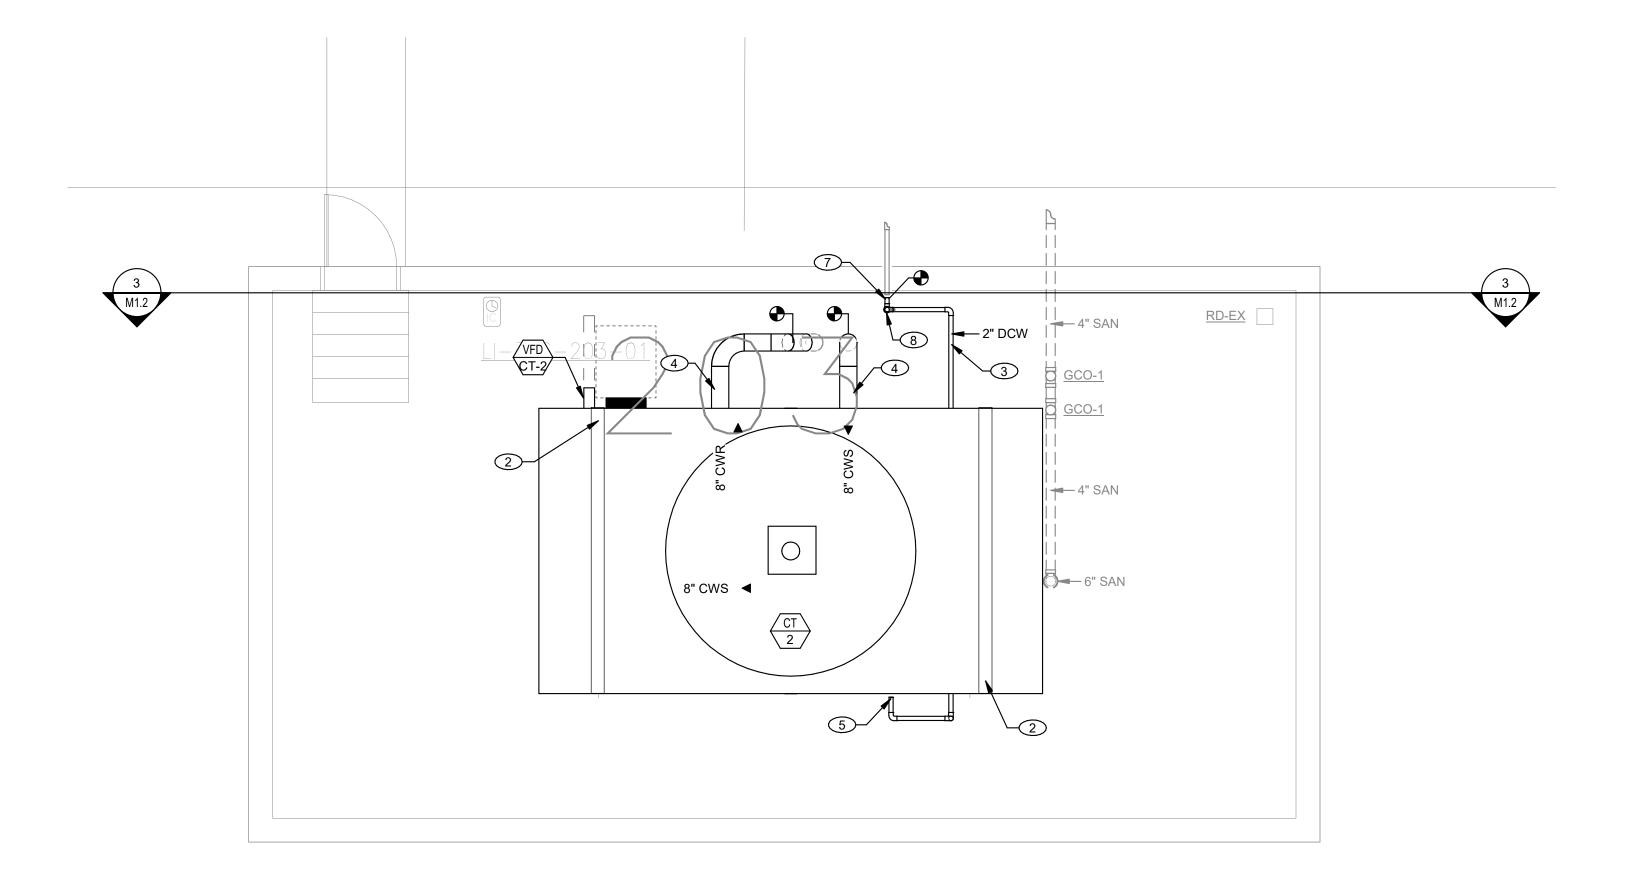










# NORTHWEST MECHANICAL



BDH#: 25023

This document and the information contained may not be reproduced or excerpted from without the express written permission of BDH Engineering, LLC. Unauthorized copying, disclosure or construction use are prohibited by the copyright law.

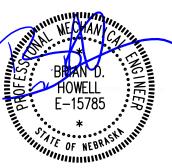

PROJECT:

SEE SHEET M0.0 FOR MECHANICAL SYMBOLS LEGEND AND

SUPPORT PIPING FROM STRUCTURE AS REQUIRED. SEE PIPE

### **KEYNOTES**

**MECHANICAL PIPING NOTES:** 

GENERAL MECHANICAL NOTES.

- PROVIDE 1" TAP AND BALL VALVE FOR CONNECTION OF NO SCALE SYSTEM. COORDINATE INSTALLATION WITH INSTALLING CONTRACTOR FOR THAT SYSTEM.
- PROVIDE 12" TALL W12X26 GALVANIZED BEAM ON EXISTING SUPPORT STRUCTURE. SECURE BEAM TO SUPPORT AND SECURE TOWER TO BEAM.
- PROVIDE HEAT TRACE ON MAKE UP WATER PIPING. HEAT TRACE SHALL BE 6 W/FT AND BE DESIGNED TO MAINTAIN THE PIPE AT 38 DEG F WITH AN OUTDOOR TEMPERATURE OF 10 DEG F. INSULATE MAKE UP WATER PIPING OVER THE HEAT TRACE WITH A MINIMUM OF 1-1/2" FIBERGLASS INSULATION AND ALUMINUM JACKETING. PROVIDE HEAT TRACE CONTROL SYSTEM TO AUTOMATICALLY MAINTAIN DESIRED TEMPERATURE. INSTALL HEAT TRACE PER MANUFACTURER RECOMMENDATIONS.
- PROVIDE HEAT TRACE ON COOLING TOWER SUPPLY AND RETURN PIPING. HEAT TRACE SHALL BE 8 W/FT AND BE DESIGNED TO MAINTAIN THE PIPE AT 38 DEG F WITH AN OUTDOOR TEMPERATURE OF 10 DEG F. INSULATE CONDENSER WATER PIPING OVER THE HEAT TRACE WITH A MINIMUM OF 1-1/2" FIBERGLASS INSULATION AND ALUMINUM JACKETING. PROVIDE HEAT TRACE CONTROL SYSTEM TO AUTOMATICALLY MAINTAIN DESIRED TEMPERATURE, INSTALL HEAT TRACE PER MANUFACTURER RECOMMENDATIONS.
- COORDINATE EXACT MAKE UP WATER CONNECTION LOCATION WITH COOLING TOWER MANUFACTURER DRAWINGS.
- 6 EXISTING CHILLER TO REMAIN. MODIFY EXISTING DOMESTIC COLD WATER TAP IN TOWER ENCLOSURE TO CLEANLY COME OUT OF THE GROUND. TURN PIPE UP AT WALL. INSULATE AND HEAT TRACE TO AT LEAST 10"
- BELOW GRADE. 8 INSTALL ISOLATION VALVE IN VERTICAL PIPING.

# OPS NORTH & NORTHWEST COOLING TOWER REPLACEMENT

OMAHA, NE

PLAN



25023 07/16/2025

10"

BOTTOM

### REMARKS:

CT-2

1. 301L STAINLESS STEEL COLLECTION AND DISTRIBUTION BASINS, GALVANIZED STEEL STRUCTURE AND CASING, GEAR DRIVE WITH MOTOR MOUNTED OUTSIDE THE AIRSTREAM, EXTENDED LUBE LINE, ENHANCED ACCOUSTICAL PERFORMANCE QUIET FAN

10"

- 2. 15 MIL PVC FILL WITH INTEGRAL LOUVERS AND DRIFT ELIMINATORS, GALVANIZED AIR INLET SCREENS, ONE 8" BOTTOM HOT WATER INLETS WITH INTEGRAL PVC PIPING FOR BALANCED DISTRIBUTION PER CELL, FLOAT TYPE MAKEUP VALVE
- 3. ACCESS DOOR PLATFORM ON BOTH CASED FACES, FAN DECK LADDER WITH SAFETY CAGE ON BOTH CASED FACES, LADDER EXTENTIONS TO GRADE, FAN DECK GUARDRAIL, FIBERGLASS VELOCITY RECOVERY STACK, AND STAINLESS STEEL PLENUM WALKWAY
- REMOTE VARIABLE FREQUENCY DRIVE WITH DISCONNECT, SHAFT GROUNDING RING, AND EXTERNALLY MOUNTED MANUAL RESET VIBRATION SWITCH
   8" DEPRESSED SIDE SUMP OUTLET WITH TRASH SCREEN AND ANTI VORTEX PLATE PER CELL, OUTLET ON BOTTOM OF TOWER. STEEL SUMP SIDE OUTLET WITH SCREEN.

1700

95/78

- 6. TOWER TO INCLUDE SINGLE POINT POWER CONTROL PANEL FOR FAN AND HEATER POWER. VFD TO BE MOUNTED REMOTE TO PANEL.
- 7. CTI CERTIFIED PER STD-201
- 8. ALTERNATE TOWER MANUFACTURERS ARE ALLOWED. CONTRACTOR RESPONSIBLE FOR ANY MODIFICATIONS FOR ALTERNATE TOWER SELECTIONS.

95/78

700

9. 5-YEAR WHOLE UNIT PARTS ONLY WARRANTY

WEST

CROSSFLOW

### NORTH AND NORTHWEST TOWER CONTROL SEQUNCE

<u>GENERAL:</u> COOLING TOWER SEQUENCE OF OPERATION IS NOT INTENDED TO MODFIY OR OVERRIDE THE EXISTING CHILLER SEQUENCE OF OPERATION. EXISTING CHILLER CONTROL POINTS LISTED IN THIS SEQUENCE ARE APPROXIMATE.

<u>COOLING TOWER ENABLE:</u> UPON CHILLER ENABLE SIGNAL THE BMS SHALL ENABLE COOLING TOWER SYSTEM AND CLOSE THE COOLING TOWER BYPASS VALVE.

<u>COOLING TOWER OPERATION:</u> BMS SHALL MONITOR THE CONDENSER WATER SUPPLY TEMPERATURE. UPON RISE IN SUPPLY TEMPERATURE ABOVE 75 DEG F THE COOLING TOWER FAN SHALL START. BMS SHALL MODULATE THE COOLING TOWER FAN VFD TO MAINTAIN CONDENSER WATER SETPOINT.

<u>CONDENSER WATER SETPOINT:</u> CONDENSER WATER SETPOINT SHALL BE SET BY THE BMS. BMS SHALL MONITOR THE OUTDOOR WET BULB TEMPERATURE AND SET THE CONDENSER WATER SUPPLY TEMPERATURE TO 7 DEG F HIGHER THAN THE ACTUAL OUTDOOR WETBULB TEMPERATURE.

<u>FAULT DETECTION:</u> BMS SHALL MONITOR THE COOLING TOWER STATUS AND FAN VIBRATION. UPON LOSS OF STATUS BMS SHALL SIGNAL AN ALARM. UPON DETECTION OF FAN VIBRATION THE BMS SHALL DISABLE THE COOLING TOWER AND SIGNAL AN ALARM AT THE BMS TERMINAL.

VARIABLE FREQUENCY DRIVE SCHEDULE								
		мот	MOTOR SIZE	ELECTRICAL		<b>AL</b>	MANUFACTURER & MODEL	
MARK	SERVES	LOCATED	(HP)	A	V	PH	NO.	REMARKS
VFD-CT-1A	COOLING TOWER CT-1	ON TOWER	15	21.0	480.0	3	YASKAWA	1
VFD-CT-1B	COOLING TOWER CT-1	ON TOWER	15	21.0	480.0	3	YASKAWA	1
VFD-CT-2	COOLING TOWER CT-2	ON TOWER	40	52.0	480.0	3	YASKAWA	1

5000

24 KW

24,420

### REMARKS:

1. VFD TO BE RATED FOR OUTDOOR OPERATION.


**GEAR** 

165,300

PIPING APPLICATION SCHEDULE							
SYSTEM DESCRIPTION	N 017F MATERIA		EDIAL LOINTO	INSULATION	INSULATION		
STSTEW DESCRIPTION	SIZE	MATERIAL	JOINTS	TYPE	THICKNESS	NOTES	
DOMESTIC COLD WATER - OUTDOOR W/ HEAT TRACE	ALL	COPPER (TYPE L)	SOLDER	FIBERGLASS WITH ALUMINUM JACKET	1"	А	
CONDENSER WATER OUTDOOR W/ HEAT TRACE	ALL	CPVC	SOLVENT	FIBERGLASS WITH ALUMINUM JACKET	1-1/2"	А	

### NOTES:

) PROVIDE ALUMINUM JACKETED INSULATION WHEN LOCATED OUTDOORS

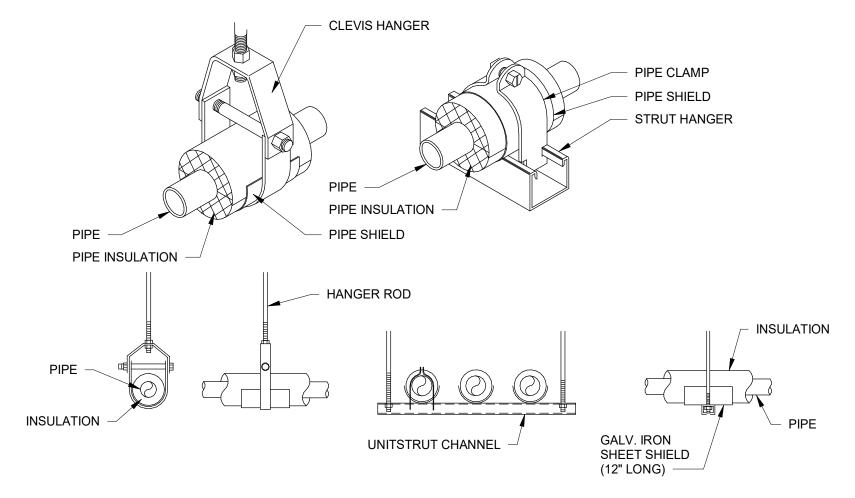

### NOTES:

- 1. ATTACH SUPPORTS FOR ALL PIPING SUSPENDED FROM THE
- STEEL STRUCTURE TO THE TOP CORD OF JOISTS OF BEAMS.

  2. PROVIDE COPPER OR PLASTIC COATED HANGERS FOR NON-INSULATED COPPER PIPE.
- INSULATED COPPER PIPE.
  3. PROVIDE AND INSTALL B-LINE OR ACCEPTABLE INSULATED
  GALVANIZED STEEL JACKET AND HANGER, STRUT MOUNTED
  CLAMP AND PIPE SUPPORT LOCATIONS.



# OPS NORTH & NORTHWEST COOLING TOWER REPLACEMENT

REMARKS

1-9

MARLEY NC8407TAN


OMAHA, NE

MECHANICAL DETAILS AND SCHEDULES



COPYRIGHT BDH#: 25023

This document and the information contained may not be reproduced or excerpted from without the express written permission of BDH Engineering, LLC. Unauthorized copying, disclosure or construction use are prohibited by the copyright law.

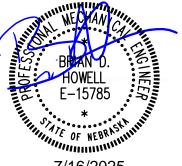

PROJECT:

M7.1

25023

			(AS APP
			(v.e.va.)
		CHING	
SYMBOL	DESCRIPTION	SYMBOL	DESCRIPTION
\$ a	SINGLE POLE SWITCH - LETTER INDICATES SWITCH LEG	\$ M	MOMENTARY CONTACT SWITCH
\$2	DOUBLE POLE SWITCH THREE-WAY SWITCH	\$ĸ	KEY OPERATED SWITCH PILOT LIGHT SWITCH
\$3 \$4	FOUR-WAY SWITCH	\$p \$ t	TIMER SWITCH
\$D	DIMMER SWITCH	\$ s	SENSOR SWITCH - WALL MOUNTED: SEE LIGHTING
\$ b \$ н	HORSEPOWER RATED SWITCH	,	CONTROL SCHEME NARRATIVE FOR TYPE
\$ F	FUSED SWITCH	<>> s,#	SENSOR - CEILING MOUNTED: SEE LIGHTING NUMBER INDICATES ZONE OF CONTROL SCHEME NARRATIVE FOR TYPE
\$TE	THERMAL ELEMENT	-<>> s,#	SENSOR - WALL MOUNTED: SEE LIGHTING CONTROLLED BY SENSOR(S).
Ha)	LIGHTING CONTROL STATION - LETTER INDICATES TYPE		CONTROL SCHEME NARRATIVE FOR TYPE NO NUMBER INDICATES ALL ROOM LUMINAIRES TO BE
		◇ DS,#	DAYLIGHTING SENSOR - CEILING MOUNTED CONTROLLED BY SENSOR(S).
	LIGH	TING	
LABEL INFORM	MATION A, # LETTER INDICATES LUMINAIRE MARK, NUMBER INDICATES A, # ZONE IDENTIFIER, NO NUMBER INDICATES SINGLE ZONE		
	LUMBARE	. 0	
	LUMINAIRE	Ю	WALL MOUNTED LUMINAIRE WALL MOUNTED LUMINAIRE - NIGHT LIGHT
	LUMINAIRE - LAMPS SWITCHED SEPARATE	H⊘ L	WALL MOUNTED LUMINAIRE - EMERGENCY
	LUMINAIRE WITH AUXILIARY LIGHT	$\bowtie$	EXIT SIGN - WALL/CEILING MOUNTED
	LUMINAIRE - EMERGENCY		EXIT SIGN/EMERGENCY LUMINAIRE COMBINATION
	LUMINAIRE - NIGHT LIGHT	$\bigotimes$	WALL/CEILING MOUNTED
	WALL MOUNTED LUMINAIRE		PHOTOCELL, DAYLIGHT SENSOR
	WALL MOUNTED LUMINAIRE - EMERGENCY	<b>←</b>	EXTERIOR LUMINAIRE - POLE MOUNTED
	WALL MOUNTED LUMINAIRE - NIGHT LIGHT	0	EXTERIOR LUMINAIRE - POLE MOUNTED
<b>⊢</b> ⊸	STRIP LUMINAIRE	<b>←</b>	EXTERIOR LUMINAIRE - POLE MOUNTED
<b>⊢</b>	STRIP LUMINAIRE - EMERGENCY	<u></u>	EXTERIOR LUMINAIRE - POLE MOUNTED
<b>⊢</b>	STRIP LUMINAIRE - NIGHT LIGHT	<b>a</b>	FLOOD LIGHT LUMINAIRE
	LUMINAIRE	$\longrightarrow$	EMERGENCY BATTERY PACK
0	LUMINAIRE - NIGHT LIGHT	<b>√</b> ⊳	EMERGENCY LUMINAIRE REMOTE HEADS
•	LUMINAIRE - EMERGENCY	$\nabla \nabla \nabla$	TRACK LUMINAIRE
	POWER	DEVICES	
		DEVIOLO	
$\Theta$	SINGLE RECEPTACLE		LIGHTING & APPLIANCE PANELBOARD
<b>+</b>	DUPLEX RECEPTACLE		POWER DISTRIBUTION EQUIPMENT
<b>#</b>	FOUR-PLEX RECEPTACLE - TWO DUPLEX RECEPTACLES	Т	TRANSFORMER
$\bigoplus$	RANGE RECEPTACLE SPECIAL RECEPTACLE		ENCLOSED CIRCUIT BREAKER
⇒G	DUPLEX RECEPTACLE - GROUND-FAULT CIRCUIT-INTERRUPTER		CABINET (TYPE INDICATED)
⇒G ⇒IG	DUPLEX RECEPTACLE - ISOLATED GROUND		MOTOR STARTER, LIGHTING CONTACTOR
	DUPLEX RECEPTACLE -		SAFETY SWITCH
₩R	WEATHER-RESISTANT GROUND-FAULT CIRCUIT-INTERRUPTER	$\boxtimes_1$	COMBINATION MOTOR STARTER & SAFETY SWITCH MOTOR
→ A	DUPLEX RECEPTACLE - ON APPLIANCE CIRCUIT		
⊕т	DUPLEX RECEPTACLE - TAMPER-RESISTANT		CORD DROP (J-BOX AT CEILING)
₽F	DUPLEX RECEPTACLE - ARC-FAULT RATED		CORD DROP (SPECIAL RECEPTACLE AT CEILING)
<b>⊕</b> M	DUPLEX RECEPTACLE - MOUNTED IN MILLWORK		MULTI-OUTLET ASSEMBLY FLUSH FLOOR BOX
— ⊕ в — ⊜	DUPLEX RECEPTACLE - MOUNTED BELOW COUNTER  DUPLEX RECEPTACLE - CEILING MOUNTED	•	FLUSH POKE-THRU
$\bigoplus$	DUPLEX RECEPTACLE - BOTTOM HALF SWITCHED		DAMPER
<b>→</b>	SPLIT-WIRE RECEPTACLE	7	
J	JUNCTION BOX	XS)	SOLENOID
	RACE	WAYS	
	HOME RUN TO PANEL		TELEPHONE CONDUIT
	UNSWITCHED LIGHTING CIRCUIT		CONDUIT UP
A	MASTER SATELLITE FIXTURE CONNECTION		CONDUIT DOWN
E	EMERGENCY CIRCUIT		CONDUIT SEAL
/ NL _	NIGHT LIGHTING CIRCUIT		CABLE TRAY
	SOUND SYSTEM RACEWAY	L	CONDUIT SLEEVE (NUMBER INDICATES SIZE)
	MISCELL	ANEOUS	
/VV			
$\langle XX \rangle$	EQUIPMENT IDENTIFICATION TAG	WP	WEATHER-PROOF
X	DETAIL REFERENCE	WG	WIRE GUARD
FACP	SHEET REFERENCE FIRE ALARM CONTROL PANEL	XP 30/3/10/3R	EXPLOSION PROOF  RATED AMPACITY/NO. POLES/FUSING REQ'D/NEMA ENCL. NO.
FAAP	FIRE ALARM ANNUNCIATOR PANEL	150/5/10/5/K ├®X	PROJECTOR INPUT STATION - LETTER INDICATES TYPE
HOA	HAND-OFF-AUTO		PROJECTOR CONTROL STATION
CCT.	CIRCUIT		LIGHT LINEWORK = EXISTING
PART. CCT.	PARTIAL CIRCUIT		DARK/DASHED LINEWORK = DEMOLITION
NF	NON-FUSED		DARK LINEWORK = NEW
		ICATIONS	
410/			
<b>⋖</b> W <b>4</b> #	TELEPHONE OUTLET - WALL MOUNTED  TELEPHONE OUTLET BOX		TELEPHONE CABINET
<b>■</b> #	NUMBER BY SYMBOL INDICATES	⊬© ↓□	CLOCK HANGER OUTLET
	PHONE OUTLET BOX - CEILING MOUNTED   INDICATES EMPTY OUTLET BOX ,	HC	CLOCK - WALL MOUNTED
#	DATA OUTLET BOX - CEILING MOUNTED  BLANK PLATE AND CONDUIT.	C 2	CLOCK - CEILING MOUNTED (DOUBLE FACE)
		CS	CLASSROOM CLOCK & SPEAKER
	WIRELESS ACCESS POINT - CEILING MOUNTED  COMBINATION TELEPHONE/DATA OUTLET BOX - ONE JACK EACH	PO	PROGRAM BELL
	DATA OUTLET BOX - BLANK PLATE, 1" CONDUIT	$\leftarrow$	INTERCOM CALL SWITCH
M #	MICROPHONE OUTLET (NUMBER INDICATES QUANTITY)	— <b>→</b> X	INTERCOM ADMINISTRATION STATION (LETTER INDICATES TYPE)
	MICROPHONE OUTLET - WALL MOUNTED (NUMBER INDICATES QUANTITY)	——D <b>x</b>	INTERCOM CLASSROOM/STAFF STATION (LETTER INDICATES TYPE)
		—⊗x	AUDIO/VISUAL AUXILIARY OUTLET (LETTER INDICATES TYPE)
L #	LINE INPUT OUTLET (NUMBER INDICATES QUANTITY)	A	T.V. ANTENNA OUTLET
H <u>L</u> #	LINE INPUT OUTLET - WALL MOUNTED (NUMBER INDICATES QUANTITY)	HV	INTERCOM/PAGING VOLUME CONTROL
S	INTERCOM/PAGING SPEAKER - CEILING MOUNTED	$\vdash \!$	SOUND SYSTEM VOLUME CONTROL
HS	INTERCOM/PAGING SPEAKER - WALL MOUNTED	<del>♦</del> ♦	GROUND BAR
⊢s◀	INTERCOM/PAGING SPEAKER HORN - WALL MOUNTED		NOTE: SYMBOLS SHOWN "STACKED" ON THE FLOOR PLANS
S	SOUND SYSTEM SPEAKER - CEILING MOUNTED		INDICATE THAT THE DEVICES ARE TO BE LOCATED IN THE SAME OUTLET BOX AND FACEPLATE. (I.E. $_{f w}$ 1 )
HS)	SOUND SYSTEM SPEAKER - WALL MOUNTED		2
			•

FIRE ALARM					
SYMBOL	DESCRIPTION	SYMBOL	DESCRIPTION		
HD R/T	HEAT DETECTOR - COMBINATION	$\bigcirc$	FIRE ALARM HORN - CEILING MOUNTED		
$\widehat{HD}_{F}$	HEAT DETECTOR - FIXED TEMPERATURE	$\otimes$	FIRE ALARM VISUAL SIGNAL - CEILING MOUNTED		
HD <sub>EV</sub>	HEAT DETECTOR - FIXED TEMPERATURE (CONNECTED TO ELEVATOR RECALL)	$\otimes \triangleleft$	FIRE ALARM COMBINATION HORN/VISUAL - CEILING MOUNTED		
_		F◀	FIRE ALARM SPEAKER - CEILING MOUNTED		
(SD)	SMOKE DETECTOR	⊚◀	FIRE ALARM COMBINATION SPEAKER/VISUAL - CEILING MOUNTED		
(SD) DM	SMOKE DETECTOR - DUCT MOUNTED		FLOW SWITCH		
SD EV	SMOKE DETECTOR (CONNECTED TO ELEVATOR RECALL)				
F	FIRE ALARM MANUAL STATION		TAMPER SWITCH		
F⊲	FIRE ALARM HORN - WALL MOUNTED		DUCT DETECTOR REMOTE ALARM INDICATOR		
	FIRE ALARM VISUAL SIGNAL - WALL MOUNTED	R	FAN SHUT-DOWN RELAY		
	FIRE ALARM COMBINATION HORN/VISUAL - WALL MOUNTED		MAGNETIC DOOR HOLDER		
F◀	FIRE ALARM SPEAKER - WALL MOUNTED	SBD□	SMOKE BEAM DETECTOR		
$\bigcirc \blacktriangleleft$	FIRE ALARM COMBINATION SPEAKER/VISUAL - WALL MOUNTED	R	SMOKE BEAM REFLECTOR		
FO	FIRE ALARM BELL - WALL MOUNTED				
	SECU	RITY			
•	PUSHBUTTON STATION	$\leftarrow$	MOTION DETECTOR		
0	PUSHBUTTON STATION, 'P' INDICATES PILOT	KP	KEYPAD		
	DOOR MONITOR SWITCH	ES	ELECTRIC STRIKE		
$\circ$	DOOR SWITCH	CR	CARD READER		
	DOOR BELL CHIME/BUZZER	PS	POWER SUPPLY		
	DOOR CONTACT		SECURITY CAMERA		
	NURSE	CALL			
E	NURSE CALL DOME LIGHT EMERGENCY CALLS ONLY	HN2	DOUBLE BED NURSE CALL STATION (2 CORD SETS)		
$\bigcirc$ N	NURSE CALL DOME LIGHT EMERGENCY/NORMAL CALLS	NC	NURSE CALL ANNUNCIATOR & POWER SUPPLY		
HE	EMERGENCY CALL SWITCH	ND	NURSE CALL DUTY STATION		
$\vdash \mathbb{B}$	CODE BLUE STATION	NS	NURSE CALL STAFF STATION		
$\vdash N$	SINGLE BED NURSE CALL STATION (1 CORD SET)				

NOTICE: DO NOT SCALE DRAWINGS. VERIFY ALL DIMENSIONS AND CLEARANCES FROM ARCHITECTURAL, STRUCTURAL, SHOP AND OTHER APPROPRIATE DRAWINGS OR AT SITE. LAY OUT AND COORDINATE ALL WORK PRIOR TO INSTALLATION TO PROVIDE CLEARANCES REQUIRED FOR OPERATION, MAINTENANCE, AND CODES. VERIFY NON-INTERFERENCE WITH OTHER WORK. DO NOT FABRICATE PRIOR TO VERIFICATION OF CLEARANCES FOR ALL TRADES. THIS NOTICE APPLIES TO ALL ELECTRICAL PLANS.

ELECTRICAL			
Sheet Number	Sheet Name		
ELECTRICAL			
E0.0	ELECTRICAL SYMBOLS LEGEND AND GENERAL NOTES		
E0.1	NORTH ELECTRICAL KEY PLAN		
E0.2	NORTHWEST ELECTRICAL KEY PLAN		
E0.3	NORTH ELECTRICAL DEMOLITION PLAN		
E0.4	NORTHWEST ELECTRICAL DEMOLITION PLAN		
E1.1	NORTH ELECTRICAL PLAN		
E1.2	NORTHWEST ELECTRICAL PLAN		
E2.1	ELECTRICAL ONE-LINE DIAGRAMS		
Grand total: 8			

### GENERAL ELECTRICAL DEMOLITION NOTES

APPLY TO ALL ELECTRICAL SHEETS

**ELECTRICAL SYMBOLS LEGEND** 

- A. COMPLETELY REMOVE ALL ELECTRICAL WIRING, CONDUIT, SWITCHES, DISCONNECTS, LUMINAIRES, AND ASSOCIATED ANCILLARY EQUIPMENT INDICATED BY BOLD, DASHED LINES OR IDENTIFIED BY NOTES. ITEMS INDICATED FOR REMOVAL ARE ONLY SUGGESTIVE OF THE AMOUNT OF DEMOLITION WORK INVOLVED. PERFORM A SITE INVESTIGATION TO AID IN DETERMINING THE COMPLETE EXTENT OF DEMOLITION WORK.
- B. COORDINATE AND SCHEDULE ALL NECESSARY POWER OUTAGES WITH THE OWNER'S REPRESENTATIVE PRIOR TO PROCEEDING WITH SUCH WORK SO OPERATIONS IN ADJACENT OCCUPIED PORTIONS OF THE BUILDING ARE NOT INTERRUPTED OR RESTRICTED WITHOUT PRIOR APPROVAL.
- C. REMOVE ALL EXISTING BRANCH CIRCUITS INDICATED AS COMPLETELY AS POSSIBLE. REMOVE EXISTING CONDUCTORS COMPLETELY FROM THEIR RACEWAYS AND DO NOT REUSE EXCEPT WHERE SPECIFICALLY INDICATED. WHERE AN EXISTING DEVICE IS REMOVED FROM AN EXISTING CIRCUIT, PROVIDE NEW WIRING AND MAINTAIN CONTINUITY OF EXISTING
- D. REMOVE EXISTING SURFACE MOUNTED BOXES, CONDUIT, SURFACE METAL RACEWAY, WIREWAY, ETC. INDICATED AS COMPLETELY AS POSSIBLE. PATCH ABANDONED PENETRATIONS FROM REMOVED FASTENERS. ABANDON IN PLACE NON-ACCESSIBLE BOXES SHOWN REMOVED AND COVER WITH STAINLESS STEEL COVER PLATES. ABANDON IN PLACE NON-ACCESSIBLE CONDUIT SHOWN REMOVED AND CAP OFF IN A SUITABLE MANNER PER LOCAL INSPECTOR'S REQUIREMENTS. CHISEL RACEWAYS STUBBED FROM A CONCRETE FLOOR OR WALL 2 INCHES BELOW ADJACENT SURFACE, GROUT, AND SCREED.
- E. COORDINATE REUSED EXISTING BOX AND CONDUIT LOCATIONS WITH NEW WORK
- F. REMOVE ELECTRICAL WORK AT ALL MECHANICAL EQUIPMENT SHOWN REMOVED. COORDINATE EQUIPMENT REMOVAL LOCATIONS WITH MECHANICAL DRAWINGS.

### GENERAL ELECTRICAL NOTES

APPLY TO ALL ELECTRICAL SHEETS

- A. MOUNTING HEIGHTS INDICATED ARE TO CENTER OF ROUGH-IN ABOVE FINISHED FLOOR (AFF).
- B. INSTALL ALL CONDUCTORS IN CONTINUOUS RACEWAY. PROVIDE INSULATED EQUIPMENT GROUNDING CONDUCTOR.
- C. PROVIDE DEDICATED NEUTRAL CONDUCTOR FOR EACH BRANCH CIRCUIT PHASE CONDUCTOR. EXCEPTION: WHERE AN EQUIPMENT MANUFACTURER REQUIRES A MULTIWIRE BRANCH CIRCUIT FOR ONLY ONE UTILIZATION EQUIPMENT AND WHERE ALL UNGROUNDED CONDUCTORS OF THAT CIRCUIT ARE OPENED SIMULTANEOUSLY BY THE BRANCH CIRCUIT OVERCURRENT DEVICE.
- D. CONCEAL ALL CONDUITS IN NEW WALLS, EXISTING STUD WALLS, OR ABOVE SUSPENDED
- E. WHERE CONDUIT CANNOT BE CONCEALED IN EXISTING WALL OR CEILING CAVITIES, INSTALL CONDUCTORS IN SURFACE METAL RACEWAYS; SURFACE CONDUIT OR METAL SURFACE RACEWAY AT ENGINEER'S DISCRETION.
- F. PAINT SURFACE CONDUIT IN FINISHED AREAS, WHEN ALLOWED, TO MATCH SURROUNDING SURFACES. COORDINATE FINISHES WITH ARCHITECT.
- G. METAL SURFACE RACEWAYS SHALL BE WIREMOLD #V500, #V700, OR #V2400 SERIES WITH FACTORY IVORY FINISH OR APPROVED EQUIVALENT. METAL SURFACE RACEWAYS FOR TELEVISION CABLE SHALL BE WIREMOLD #V700 OR LARGER. METAL SURFACE RACEWAYS FOR TELECOMMUNICATIONS CABLES SHALL BE #V2400 OR LARGER. COMPLY WITH EIA/TIA STANDARDS FOR CABLE BENDING RADIUS.
- H. INSTALL EXPOSED OR CONCEALED RACEWAY NEAR METAL CORRUGATED SHEET ROOF DECKING SO NEAREST OUTER RACEWAY SURFACE IS NOT LESS THAN 6 INCHES FROM THE NEAREST SURFACE OF THE ROOF DECKING. EXCEPTION: RIGID METAL CONDUIT AND INTERMEDIATE METAL CONDUIT SHALL NOT BE REQUIRED TO MAINTAIN THIS CLEARANCE.
- I. PATCH, PAINT, REPAIR OR REPLACE ALL WALLS, CEILINGS, OR OTHER BUILDING ELEMENTS DISTURBED DURING INSTALLATION OF ELECTRICAL WORK.
- J. USE ROOM NUMBERS ASSIGNED BY OWNER AND NOT ROOM NUMBERS LISTED ON DRAWINGS FOR LABELING OF PANELBOARD DIRECTORIES, FIRE ALARM PANEL PROGRAMMING, ETC. INCLUDE A DESCRIPTION OF LOAD SUCH AS LIGHTS, RECEPTACLES, MECHANICAL UNIT LOCATIONS, ETC. ON TYPED PANELBOARD DIRECTORIES.
- K. REFER TO MECHANICAL/ELECTRICAL COORDINATION SCHEDULE SHEET FOR ADDITIONAL REQUIREMENTS ON DISCONNECTS, MOTOR STARTERS, ETC.

## OPS NORTH & NORTHWEST COOLING TOWER REPLACEMENT


OMAHA, NE

**ELECTRICAL SYMBOLS** LEGEND AND GENERAL NOTES




BDH#: 25023

COPYRIGHT This document and the information contained may not be reproduced or excerpted from without the express written permission of BDH Engineering, LLC. Unauthorized copying, disclosure or construction use are prohibited by the copyright law.

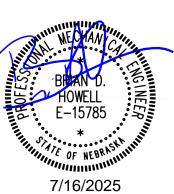



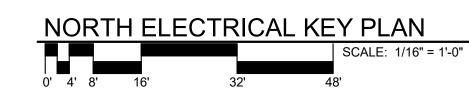

**KEYNOTES** 

PROVIDE (2) 3/4" CONDUITS WITH 2-#12, 1-#12 GRND FROM AVAILABLE (2) 20A, 1P SPACES OR SPARES IN EXISTING 208Y/120V PANEL IN BASEMENT TO COOLING TOWER.

EXISTING 1 1/2" EMT CONDUIT FROM BASEMENT TO COOLING TOWER LOCATION. REMOVE EXISTING CONDUCTORS AND REPLACE WITH NEW (2) SETS OF 3-#4, 1-#8 GRND IN EXISTING 1

ROUTE CONDUITS UP EXTERIOR WALL AND ACROSS BUILDING

ON ROOFTOP. FIELD VERIFY 120/208V PANEL THAT IS SERVED BY INDICATED 480V-208Y/120V TRANSFORMER.

mmmmmm

REMOVE PORTION OF EXISTING 1-1/2" EMT CONDUIT TO THIS POINT AND EXTEND TO EXISTING SWITCHBOARD.

2 ADDENDUM #2

07/25/2025


# **OPS NORTH &** NORTHWEST COOLING

NORTH ELECTRICAL KEY



This document and the information contained may not be reproduced or excerpted from without the express written permission of BDH Engineering,

LLC. Unauthorized copying, disclosure or construction use are prohibited by the copyright law.

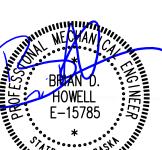

PROJECT:

25023 07/16/2025

TOWER REPLACEMENT

OMAHA, NE

PLAN

AVAILABLE (2) 20A, 1P SPACES OR SPARES IN EXISTING 208Y/120V PANEL IN BASEMENT TO COOLING TOWER.

PROVIDE (2) 3/4" CONDUITS WITH 2-#12, 1-#12 GRND FROM

2 ADDENDUM #2

07/25/2025

# OPS NORTH & NORTHWEST COOLING TOWER REPLACEMENT

OMAHA, NE


NORTHWEST ELECTRICAL KEY PLAN



BDH Engineering 440 Regency Parkwa Suite 135 Omaha, NE 68114 bdhengineer.com

COPYRIGHT BDH#: 25023


This document and the information contained may not be reproduced or excerpted from without the express written permission of BDH Engineering, LLC. Unauthorized copying, disclosure or construction use are prohibited by the copyright law.

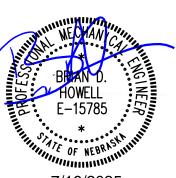

PROJECT:

CT: 25023 07/16/2025

E0.2

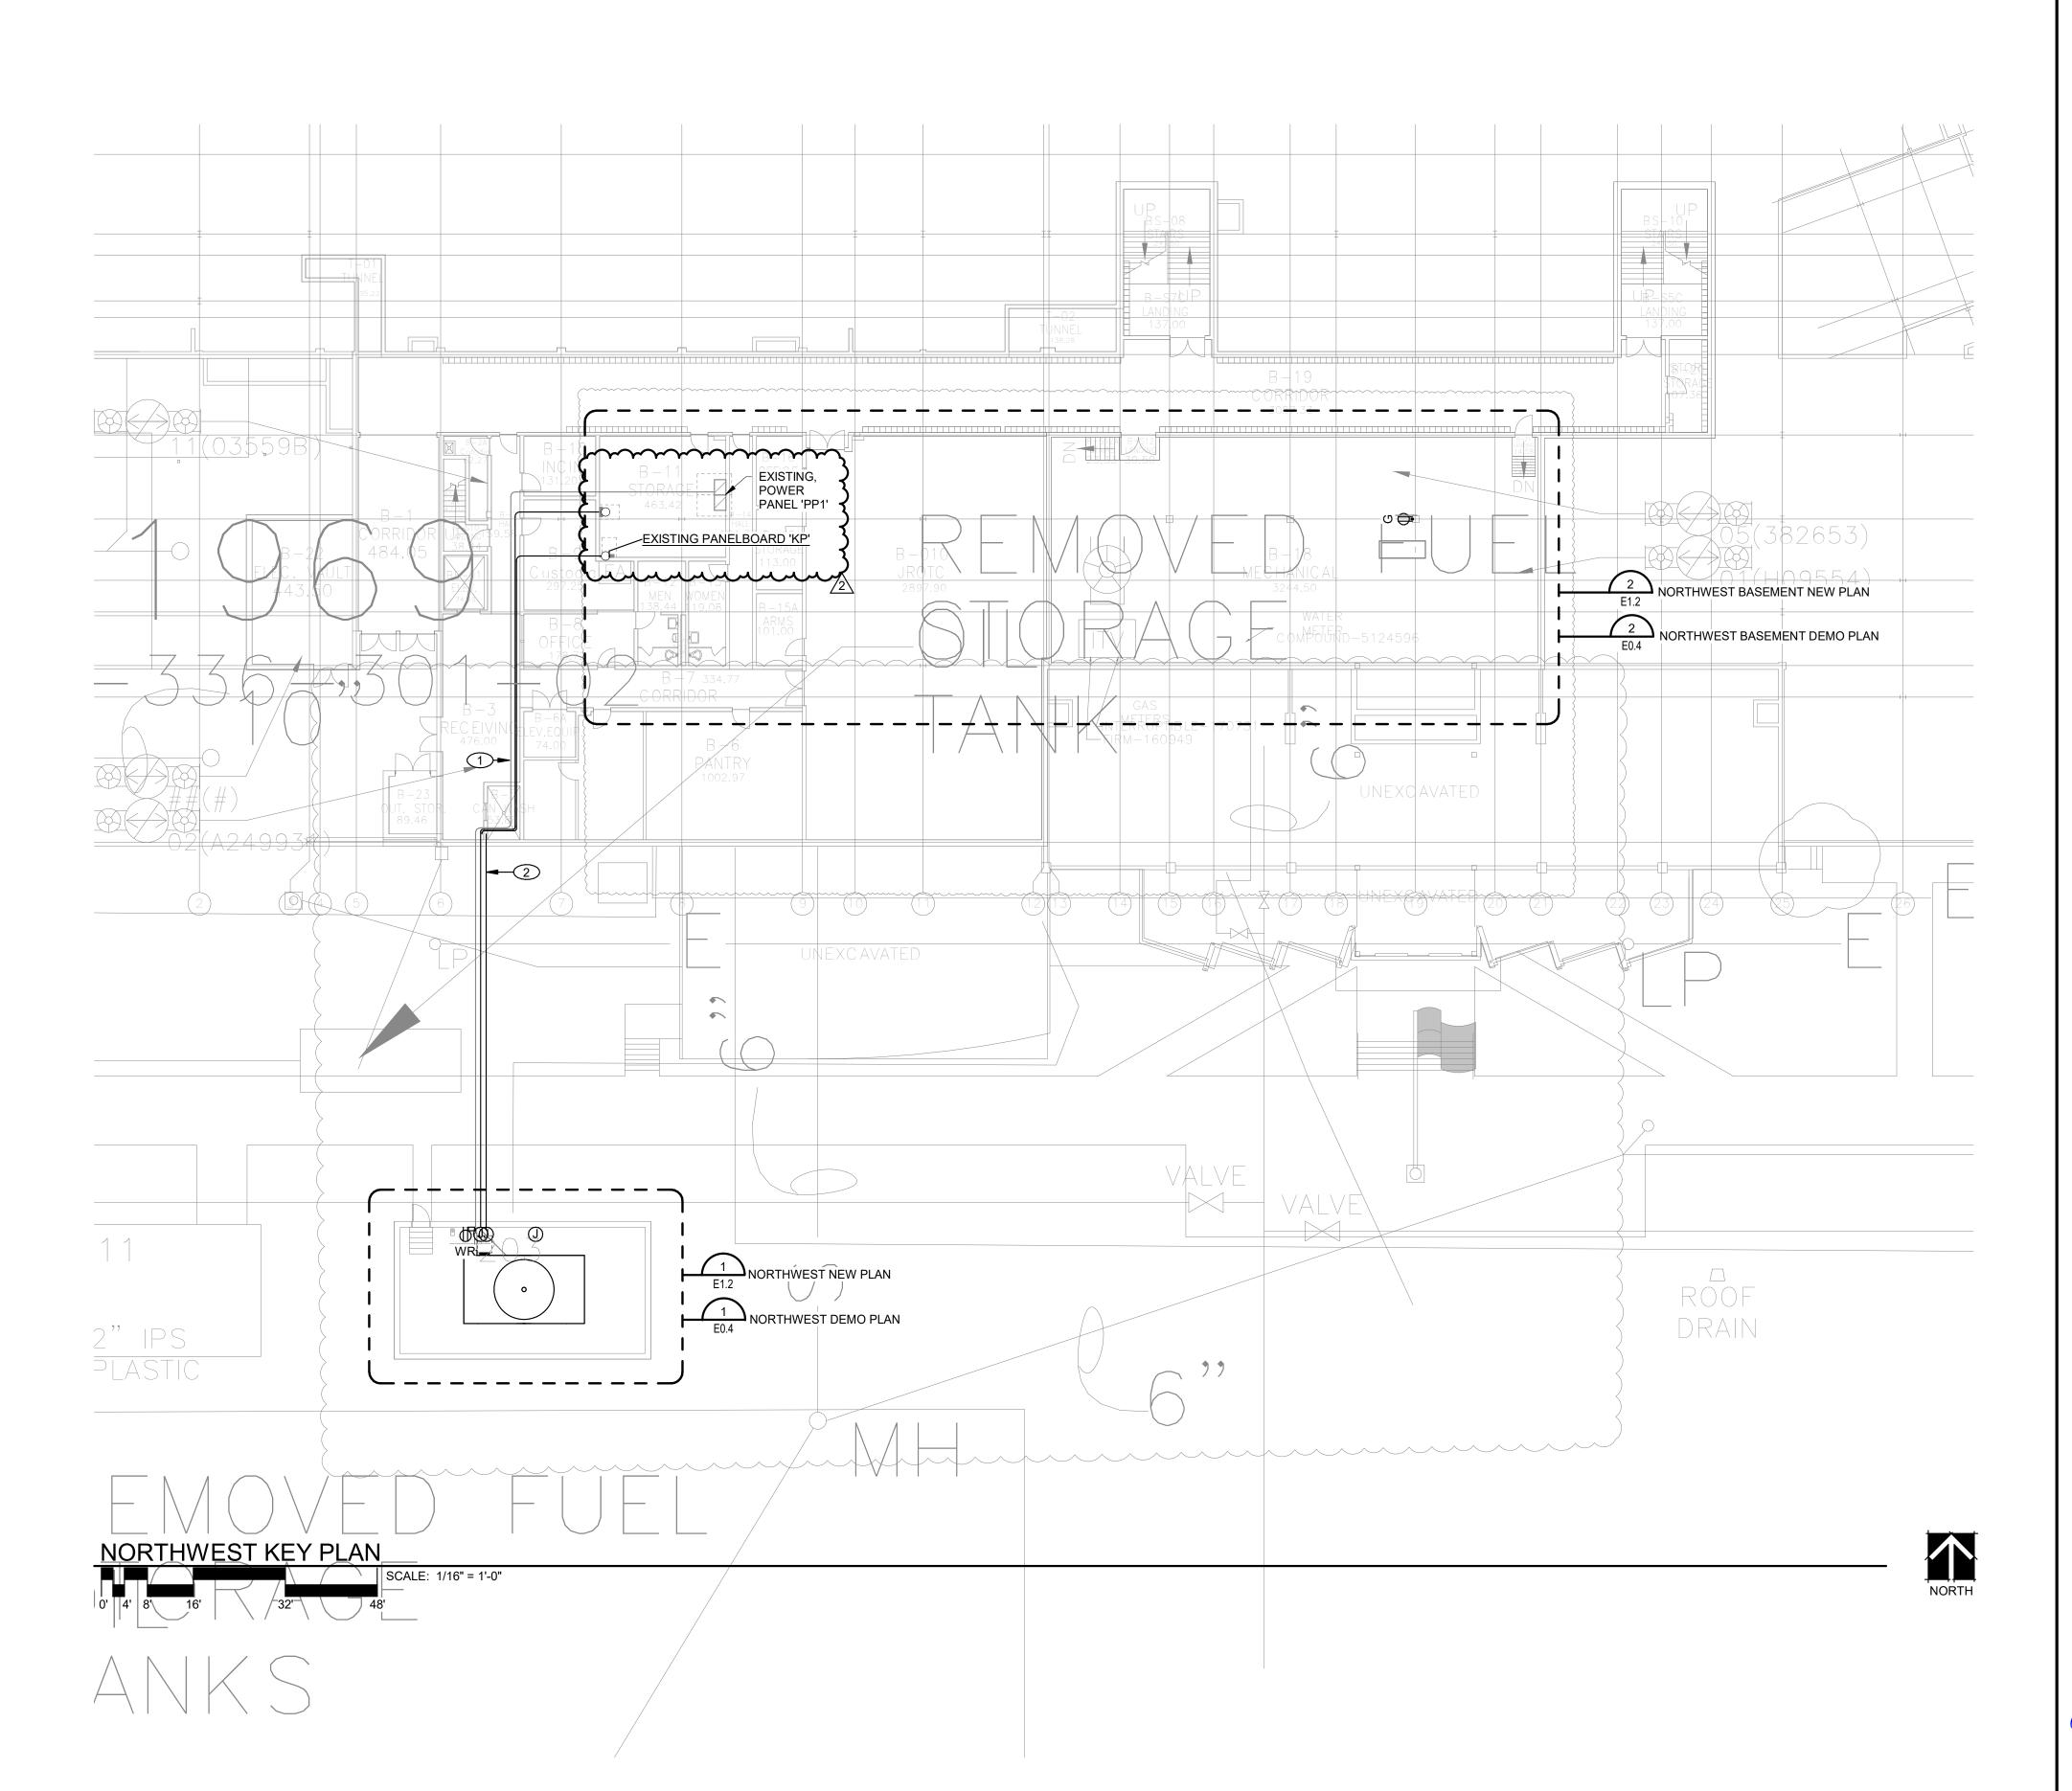

7/52/2

k Docs://25023 OPS North and Northwest Cooling 25023-OPSNorth&NorthwestCoolingTowers BDH

**ELECTRICAL DEMOLITION NOTES:** 

SEE SHEET E0.0 FOR ELECTRICAL SYMBOLS LEGEND AND GENERAL ELECTRICAL DEMOLITION NOTES.

EXISTING 1 1/2" EMT CONDUIT FROM BASEMENT TO COOLING TOWER LOCATION. REMOVE EXISTING CONDUCTORS AND REMOVE PORTION OF 1 1/2" CONDUIT FROM POINT INDICATED TO MCC-A.

REMOVE VFD'S. REMOVED ASSOCIATED LINE AND LOAD SIDE CONDUIT AND CONDUCTORS.

3 REMOVE EXISTING 60A DISCONNECT. 4 REMOVE EXISTING 1" CONDUIT AND CONDUCTORS.

EXISTING 1 1/2" EMT CONDUIT FROM BASEMENT TO COOLING TOWER LOCATION. REMOVE EXISTING CONDUCTORS AND REPLACE WITH NEW (2) SETS OF 3-#4, 1-#8 GRND IN EXISTING 1 1/2" CONDUIT. 6 REMOVE 6X6X4 JUNCTION BOX

2 ADDENDUM #2

07/25/2025

# OPS NORTH & NORTHWEST COOLING TOWER REPLACEMENT

OMAHA, NE

NORTH ELECTRICAL **DEMOLITION PLAN** 



This document and the information contained may not be reproduced or excerpted from without the express written permission of BDH Engineering, LLC. Unauthorized copying, disclosure or construction use are prohibited by the copyright law.

7/16/2025

PROJECT: 07/16/2025 DATE:

E0.3

25023

EXISTING MOTOR CONTROL CENTER EXISTING MAIN★ SWITCHGEAR NORTH BASEMENT ELECTRICAL DEMOLITION PLAN

SCALE: 3/16" = 1'-0" 4 136A 126B NORTH ELECTRICAL DEMOLITION PLAN


SCALE: 3/16" = 1'-0"

16'

NORTHWEST BASEMENT ELECTRICAL DEMOLITION PLAN

SCALE: 1/8" = 1'-0"



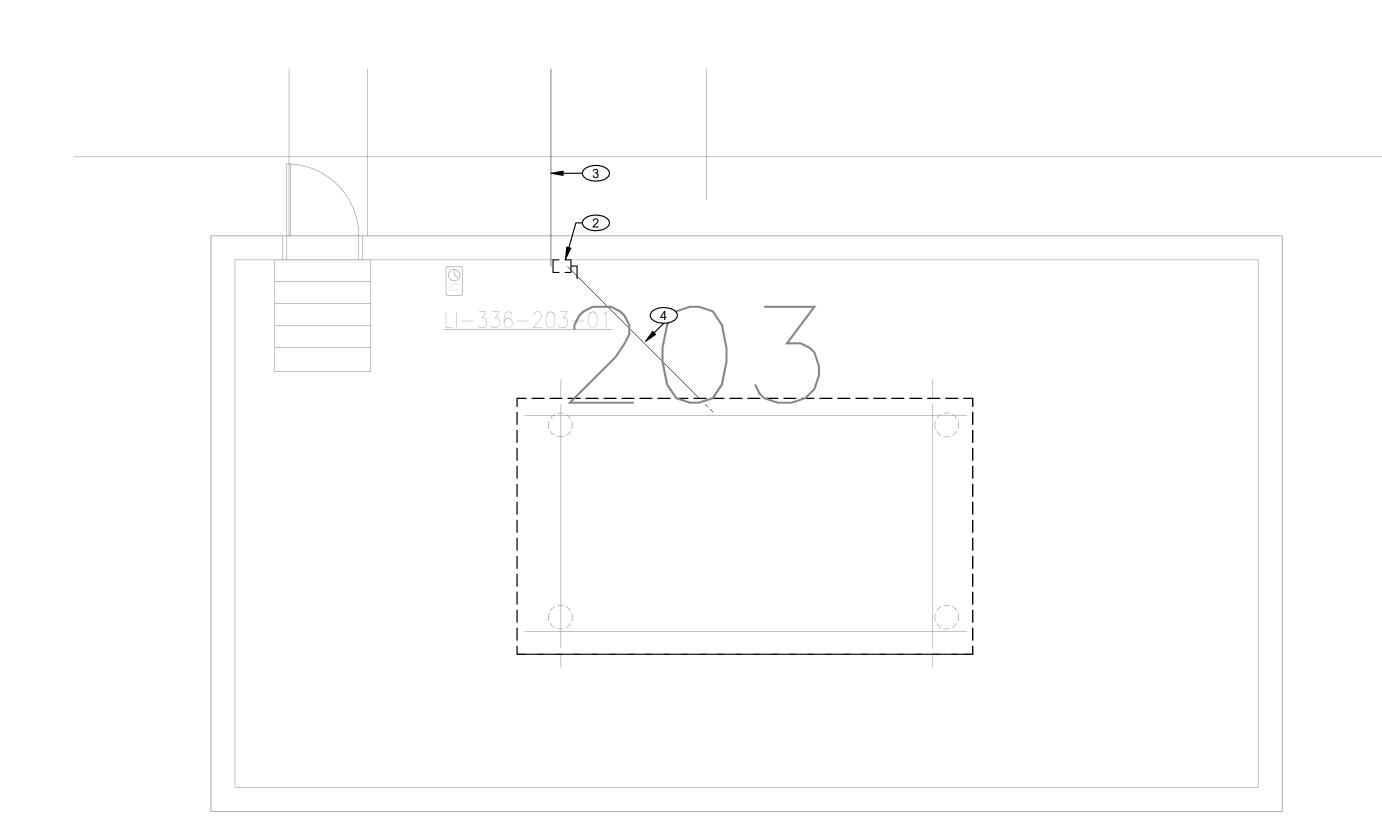





### **ELECTRICAL DEMOLITION NOTES:**

SEE SHEET E0.0 FOR ELECTRICAL SYMBOLS LEGEND AND GENERAL ELECTRICAL DEMOLITION NOTES.

## KEYNOTES

- REMOVE VFD'S. REMOVED ASSOCIATED LINE AND LOAD SIDE CONDUIT AND CONDUCTORS.

  REMOVE EXISTING 60A DISCONNECT.
- 3 EXISTING 1 1/2" EMT CONDUIT FROM BASEMENT TO COOLING TOWER LOCATION. REMOVE EXISTING CONDUCTORS AND PROVIDE WITH NEW (3) #1/0 AWG, CU, THWN, (1) #6 AWG GRND IN EXISTING 1 1/2" CONDUIT.
- EXISTING 1 1/2" EMT CONDUIT FROM EXISTING DISCONNECT TO EXISTING COOLING TOWER LOCATION. REMOVE EXISTING CONDUCTORS AND REPLACE WITH NEW (3) #1/0 AWG, CU, THWN, (1) #6 AWG, CU, THWN, GRND. REUSE EXISTING CONDUIT TO PROVIDE POWER TO NEW COOLING TOWER.

5 EXISTING CHILLER TO REMAIN.

2 ADDENDUM #2

07/25/2025

# OPS NORTH & NORTHWEST COOLING TOWER REPLACEMENT

OMAHA, NE


NORTHWEST ELECTRICAL DEMOLITION PLAN



440 Regency Parkway Suite 135 Omaha, NE 68114 bdhengineer.com

COPYRIGHT BDH#: 25023

This document and the information contained may not be reproduced or excerpted from without the express written permission of BDH Engineering, LLC. Unauthorized copying, disclosure or construction use are prohibited by the copyright law.

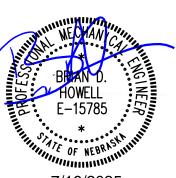

PROJECT:
DATE:

CT: 25023 07/16/2025

E0.4

SEE SHEET E0.0 FOR ELECTRICAL SYMBOLS LEGEND AND GENERAL ELECTRICAL NOTES.

SEE MECHANICAL AND ELECTRICAL SCHEDULE ON M7.1 FOR ADDITIONAL INFORMATION ON MECHANICAL EQUIPMENT REQUIRING POWER.

### **KEYNOTES**

- EXISTING 1 1/2" EMT CONDUIT FROM BASEMENT TO COOLING TOWER LOCATION. REMOVE EXISTING CONDUCTORS AND REPLACE WITH NEW (2) SETS OF 3-#4, 1-#8 GRND IN EXISTING 1 1/2" CONDUIT.
- PROVIDE 1" CONDUIT WITH 3-#4 AWG, 1-#8 AWG, GRND FROM NEW J-BOX TO NEW DISCONNECT SWITCH. PROVIDE 3-#4, 1-#8 GRND IN 1" CONDUIT FROM NEW DISCONNECT TO FACTORY PROVIDED AND INSTALLED PANEL.
  - FACTORY PROVIDED AND INSTALLED PANEL. VERIFY LOCATION. PROVIDE 1" CONDUIT FROM FACTORY PANEL TO VFD'S AND VFD'S TO FAN CONNECTIONS. PROVIDE 3/4" FROM FACTORY PROVIDED PANEL TO FACTORY PROVIDED BASIN
  - HEATERS. PROVIDE 3-#8, 1-#10 GRND. PROVIDE (2) 3/4" CONDUITS WITH 2-#12, 1-#12 GRND FROM AVAILABLE (2) 20A, 1P SPACES OR SPARES IN EXISTING 208Y/120V PANEL IN BASEMENT TO COOLING TOWER.
- VARIABLE FREQ DRIVES PROVIDED WITH COOLING TOWER. PROVIDE NEW NEMA 3R, 100A, 480V, 3P, NON-FUSED DISCONNECT. EXTEND CONDUIT FROM DISCONNECT TO TOWER SINGLE POINT CONNECTION PANEL.
- PROVIDE J-BOX FOR CONNECTION OF COOLING TOWER CONTROL CIRCUIT. TERMINATE CONDUIT AT CONTROL BOX LOCATION. PROVIDE 120V JUNCTION BOX FOR CONNECTION OF HEAT
- TRACE FOR PIPING. COORDINATE WITH MECHANICAL. EXTEND EXISTING 1-1/2" EMT CONDUIT FROM POINT INDICATED TO EXISTING SWITCHBOARD IN SUB BASEMENT. ROUTE (2) SETS OF 3-#4, 1-#8 GROUND IN 1-1/2" CONDUIT TO (2) 100À (
- SPARE BREAKERS IN SWITCHBOARD. REPLACE 100A THERMAL PLUG WITH 80A THERMAL PLUG. EXISTING CHILLER TO REMAIN. PROVIDE GFI RECEPTACLE FOR NEW SCALE FREE SYSTEM.
- NON-OVERLOADED CIRCUIT. 13 FIELD VERIFY 120/208V PANEL THAT IS SERVED BY INDICATED 480YC08Y/120VTRANSFORMEBULLING

COORDINATE LOCATION WITH SCALE FREE SYSTEM INSTALLING CONTRACTOR. CIRCUIT GFI TO NEAREST 120V

2 ADDENDUM #2

14 PROVIDE NEW NEMA 3R 12"X12"X4 J-BOX

07/25/2025


# OPS NORTH & NORTHWEST COOLING TOWER REPLACEMENT

OMAHA, NE

NORTH ELECTRICAL PLAN



This document and the information contained may not be reproduced or excerpted from without the express written permission of BDH Engineering, LLC. Unauthorized copying, disclosure or construction use are prohibited by the copyright law.

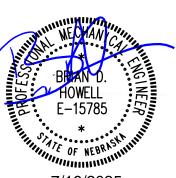

PROJECT: 07/16/2025 DATE:

25023

EXISTING, BMS CONTROL PANEL EXISTING MOTOR CONTROL CENTER - EXISTING, MAIN SWITCHBOARD munumumum m NORTH BASEMENT ELECTRICAL PLAN

SCALE: 3/16" = 1'-0"

16' 9 6 The state of the s NORTH ELECTRICAL PLAN


E1.1


O' 2' 4' 8' 16'








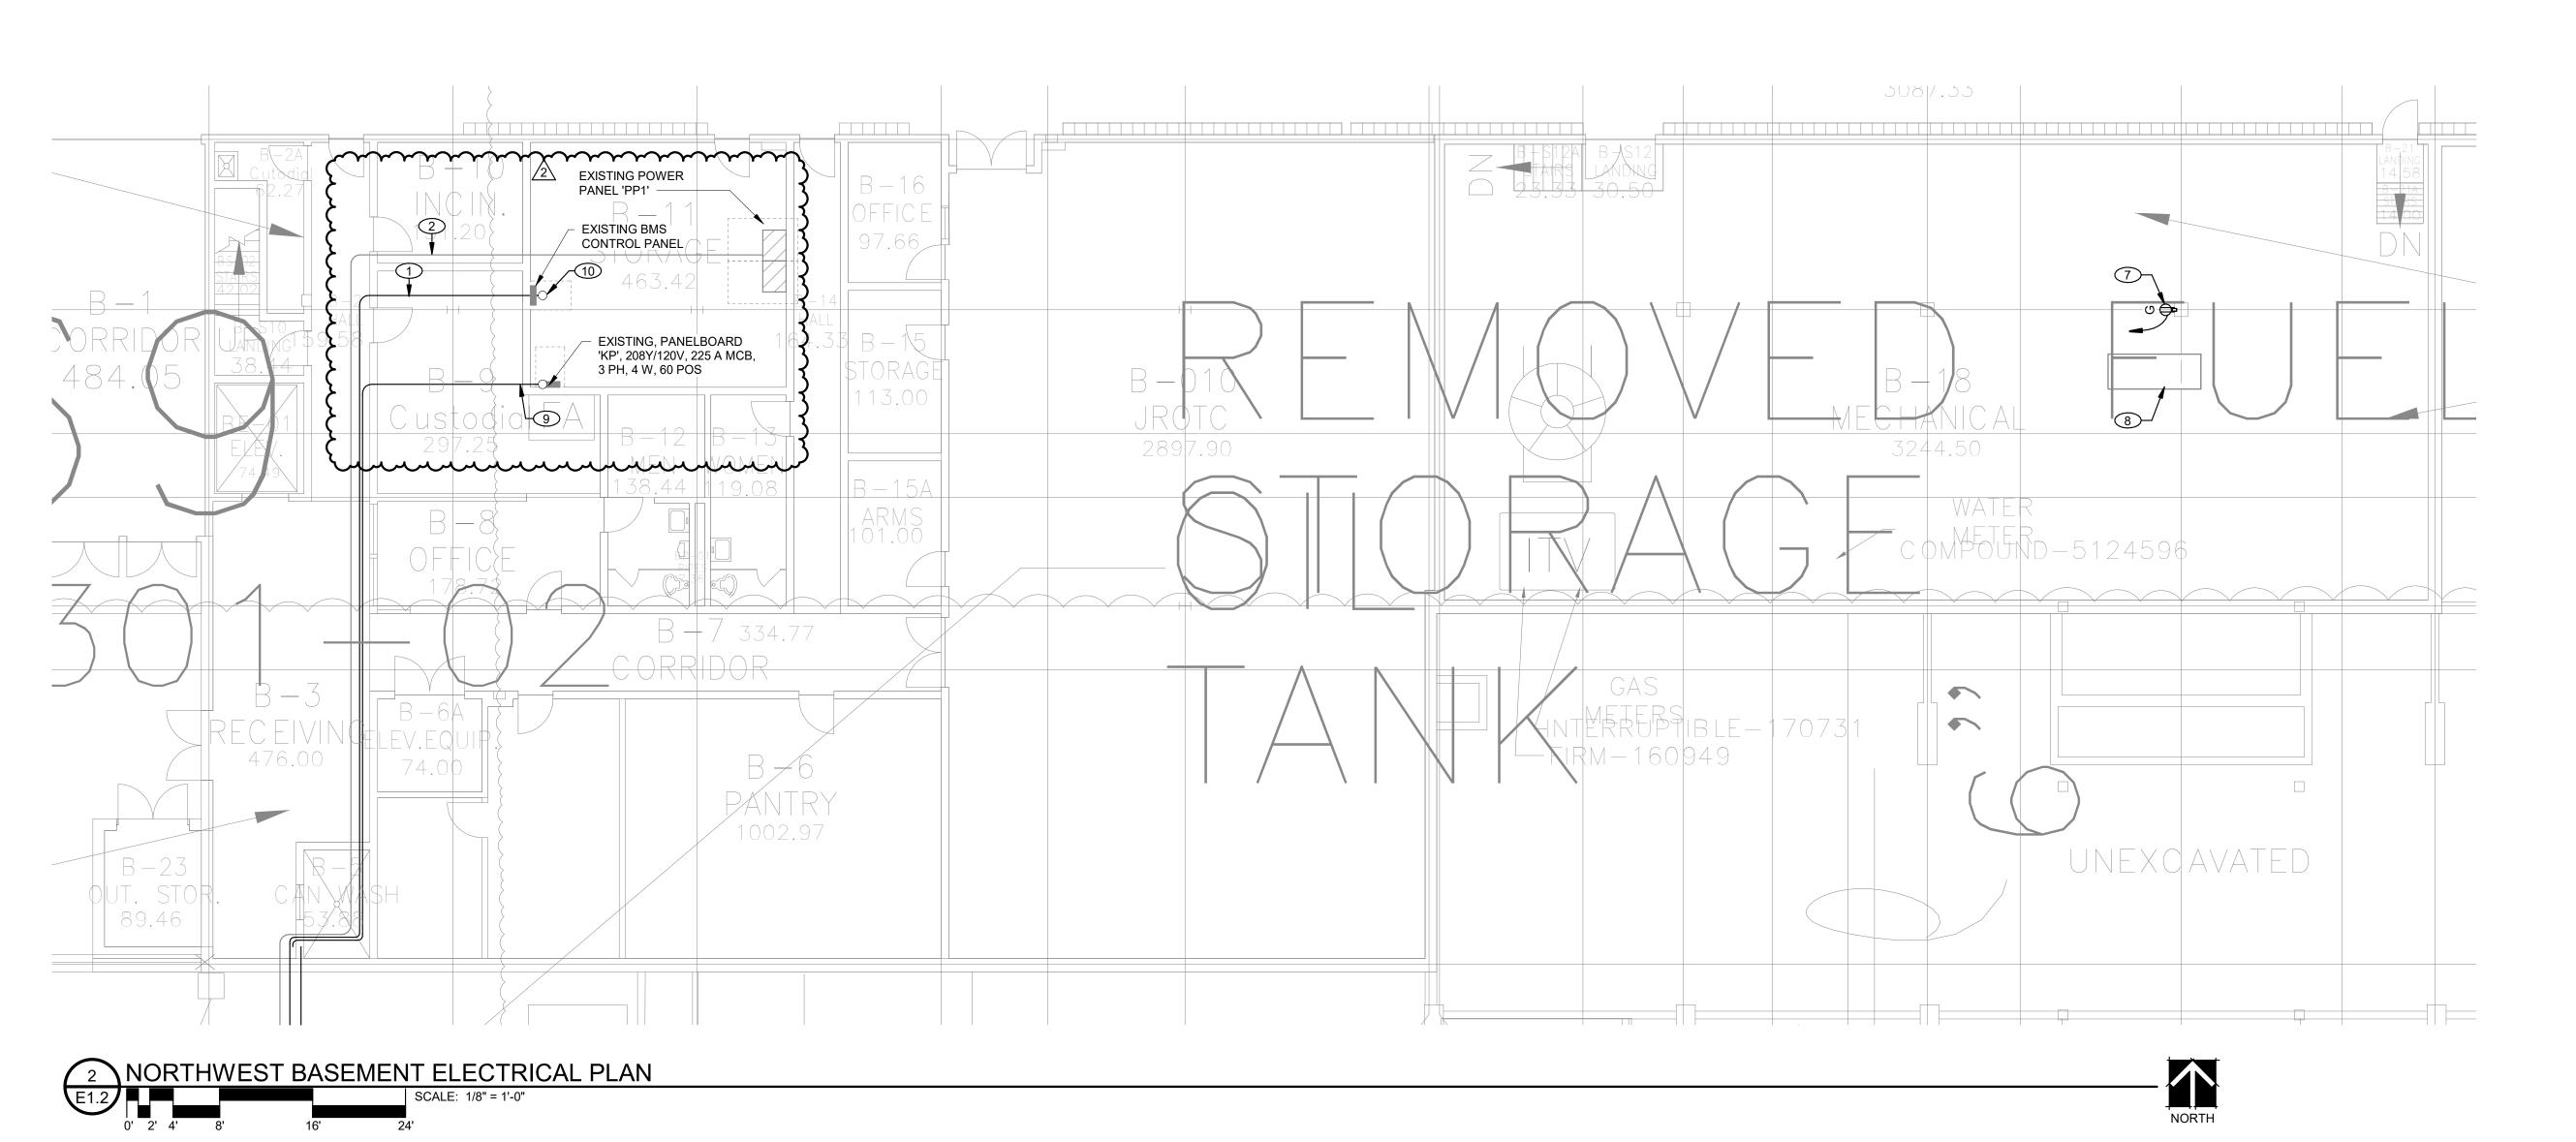

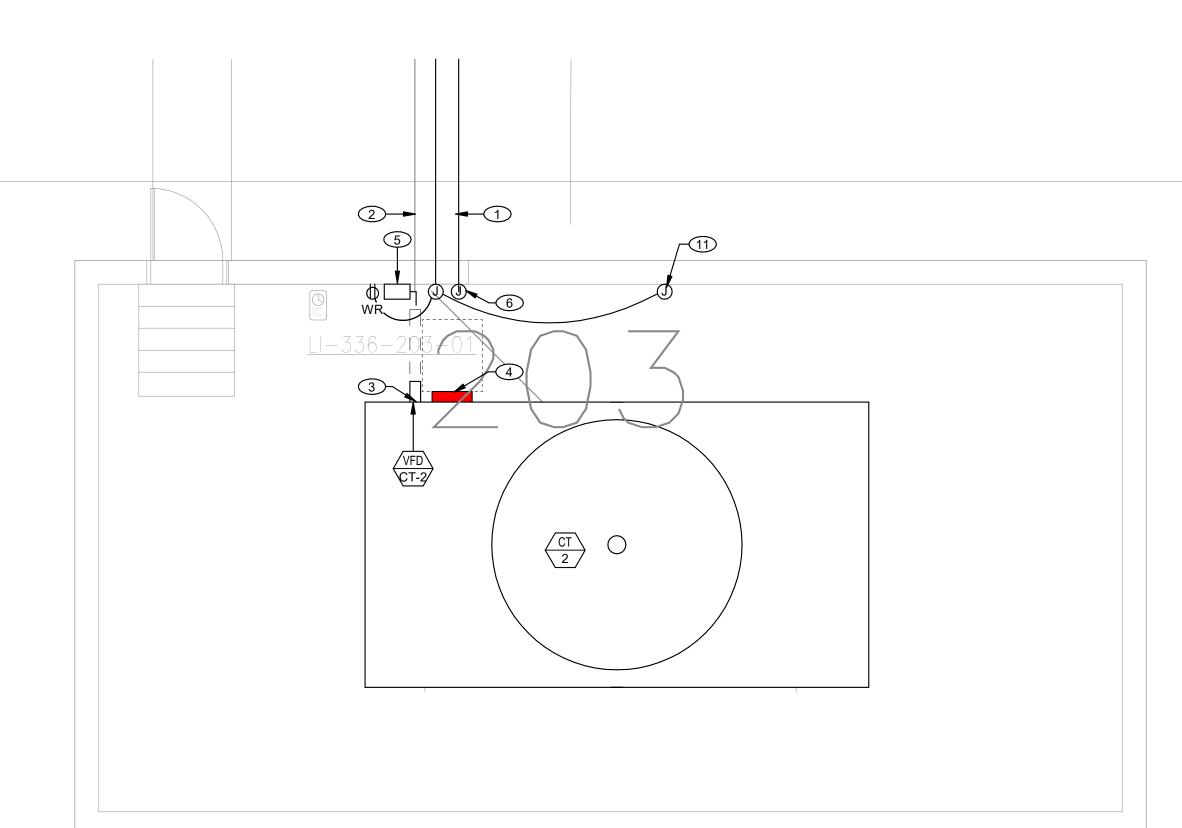

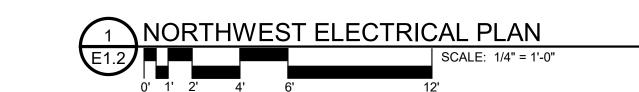



A. SEE SHEET E0.0 FOR ELECTRICAL SYMBOLS LEGEND AND GENERAL ELECTRICAL NOTES.

SEE MECHANICAL AND ELECTRICAL SCHEDULE ON M7.1 FOR

## ADDITIONAL INFORMATION ON MECHANICAL EQUIPMENT REQUIRING POWER.

### KEYNOTES

- PROVIDE (2) 3/4" CONDUITS WITH 2-#12, 1-#12 GRND FROM AVAILABLE (2) 20A, 1P SPACES OR SPARES IN EXISTING 208Y/120V PANEL 'KP' IN BASEMENT.
- EXISTING 1 1/2" EMT CONDUIT FROM BASEMENT TO COOLING TOWER LOCATION. REMOVE EXISTING CONDUCTORS AND PROVIDE WITH NEW (3) #1/0 AWG, CU, THWN, (1) #6 AWG GRND IN EXISTING 1 1/2" CONDUIT.
- VARIABLE FREQ DRIVES PROVIDED WITH COOLING TOWER.

  FACTORY PROVIDED AND INSTALLED PANEL. VERIFY
  LOCATION. PROVIDE 1" CONDUIT FROM FACTORY PANEL TO
  VFD'S AND VFD'S TO FAN CONNECTIONS. PROVIDE 3/4" FROM
  FACTORY PROVIDED PANEL TO FACTORY PROVIDED BASIN
- VFD'S AND VFD'S TO FAN CONNECTIONS. PROVIDE 3/4" FROM FACTORY PROVIDED PANEL TO FACTORY PROVIDED BASIN HEATERS. PROVIDE 3-#8, 1-#10 GRND.

  PROVIDE NEW NEMA 3R, 200A, 480V, 3P, NON-FUSED
- DISCONNECT. EXTEND CONDUIT FROM DISCONNECT TO TOWER SINGLE POINT CONNECTION PANEL.

  6 PROVIDE J-BOX FOR CONNECTION OF COOLING TOWER CONTROL CIRCUIT.
- 7 PROVIDE GFI RECEPTACLE FOR NEW SCALE FREE SYSTEM.
  COORDINATE LOCATION WITH SCALE FREE SYSTEM
  INSTALLING CONTRACTOR. CIRCUIT GFI TO NEAREST 120V
- INSTALLING CONTRACTOR. CIRCUIT GFITO NEAREST 120V NON-OVERLOADED CIRCUIT.

  EXISTING CHILLER TO REMAIN.

  TERMINATE CONDUIT IN 208/120 PANEL WITH 20A SPARE.
- PROVIDE 120V, 20A 1P BREAKERS AS REQUIRED IN AVAILABLE SPACES IN PANEL.
- TERMINATE CONDUIT AT CONTROL BOX LOCATION.

  PROVIDE 120V JUNCTION BOX FOR CONNECTION OF HEAT TRACE FOR PIPING. COORDINATE WITH MECHANICAL.

07/25/2025

2 ADDENDUM #2

OPS NORTH & NORTHWEST COOLING TOWER REPLACEMENT

OMAHA, NE


NORTHWEST ELECTRICAL PLAN



COPYRIGHT BDH#: 25023

This document and the information contained may not be reproduced or excerpted from without the express written permission of RDH Engineering.

This document and the information contained may not be reproduced or excerpted from without the express written permission of BDH Engineering, LLC. Unauthorized copying, disclosure or construction use are prohibited by the copyright law.

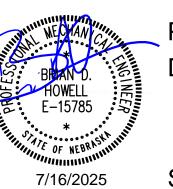


PROJECT:

DATE: (

E1.2

25023

07/16/2025

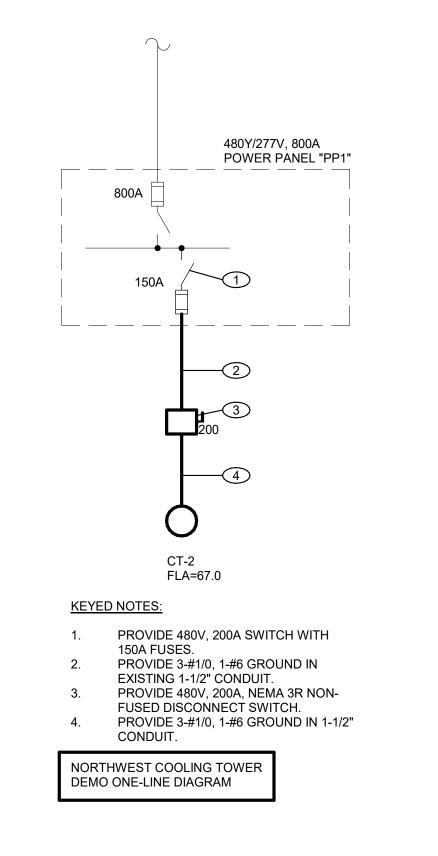

480Y/277V, 800A

800A

POWER PANEL "PP1"

2 ADDENDUM #2

07/25/2025


## OPS NORTH & NORTHWEST COOLING TOWER REPLACEMENT

OMAHA, NE

**ELECTRICAL ONE-LINE** DIAGRAMS



COPYRIGHT This document and the information contained may not be reproduced or excerpted from without the express written permission of BDH Engineering, LLC. Unauthorized copying, disclosure or construction use are prohibited by the copyright law.

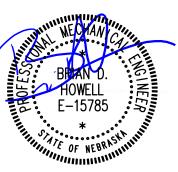

PROJECT:

25023